


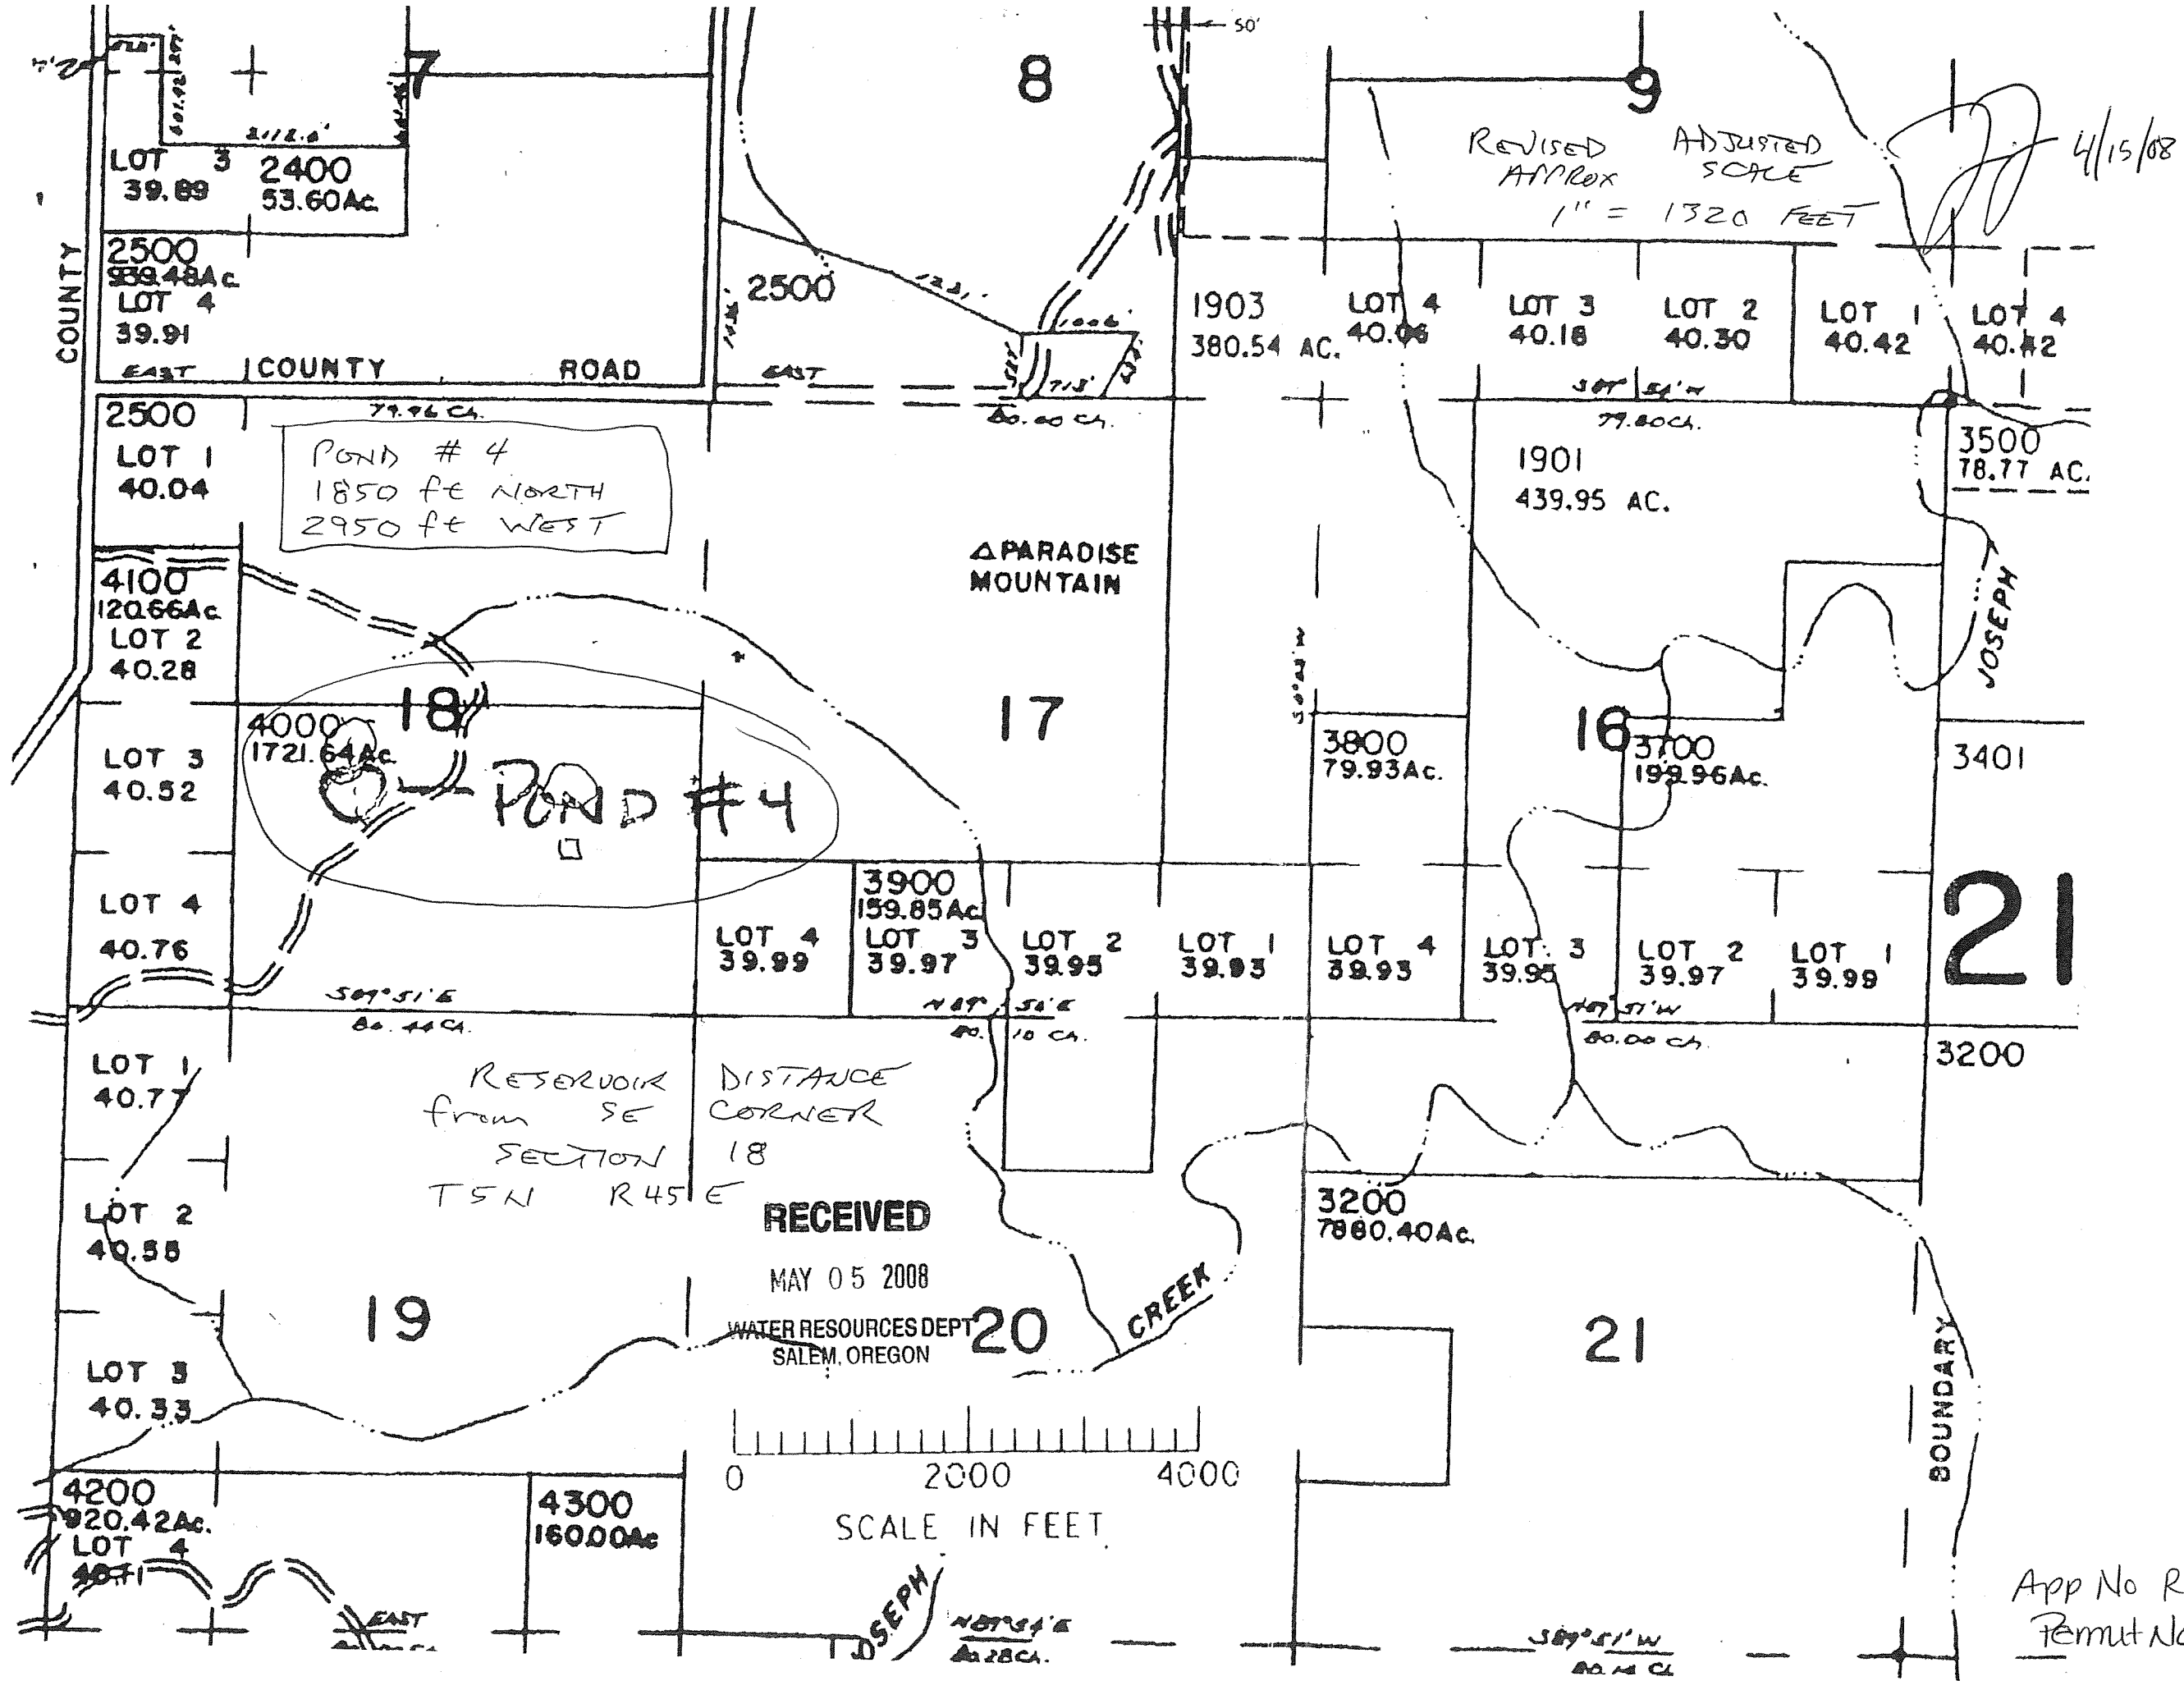

RECEIVED BY OWRD

SEP 30 2015

App No R87167
Permit No R 14624
SALEM, OR