
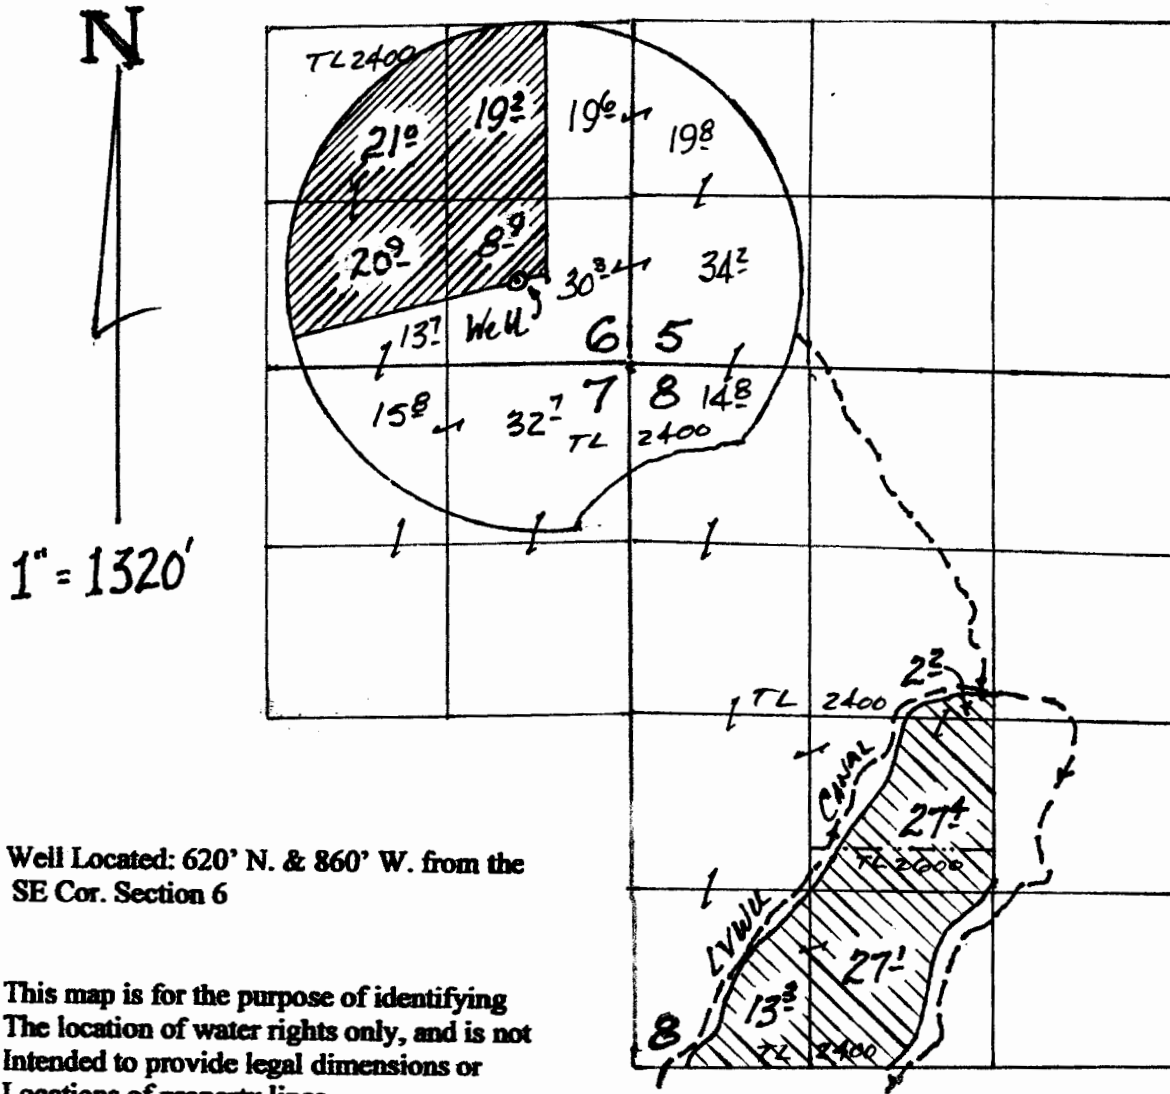


T. 39 S., R. 19 E., WM

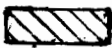


Well Located: 620' N. & 860' W. from the
SE Cor. Section 6

This map is for the purpose of identifying
The location of water rights only, and is not
intended to provide legal dimensions or
Locations of property lines.

 FROM LANDS
 TO LANDS

Map to Accompany Application
For Transfer
In the Name of Shine Brothers Ranch, LLC
Certificate 89370

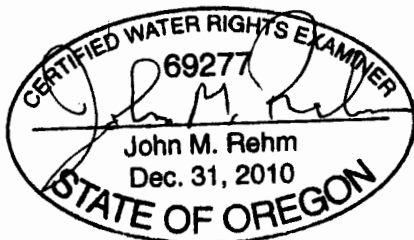

RECEIVED
NOV. 30 2015
OWRD

1 12206


11/2015 *SR*

RECEIVED

APR 25 2014


WATER RESOURCES DEPT
SALEM, OREGON

T.38 & 39 S., R.19 E., W.M.

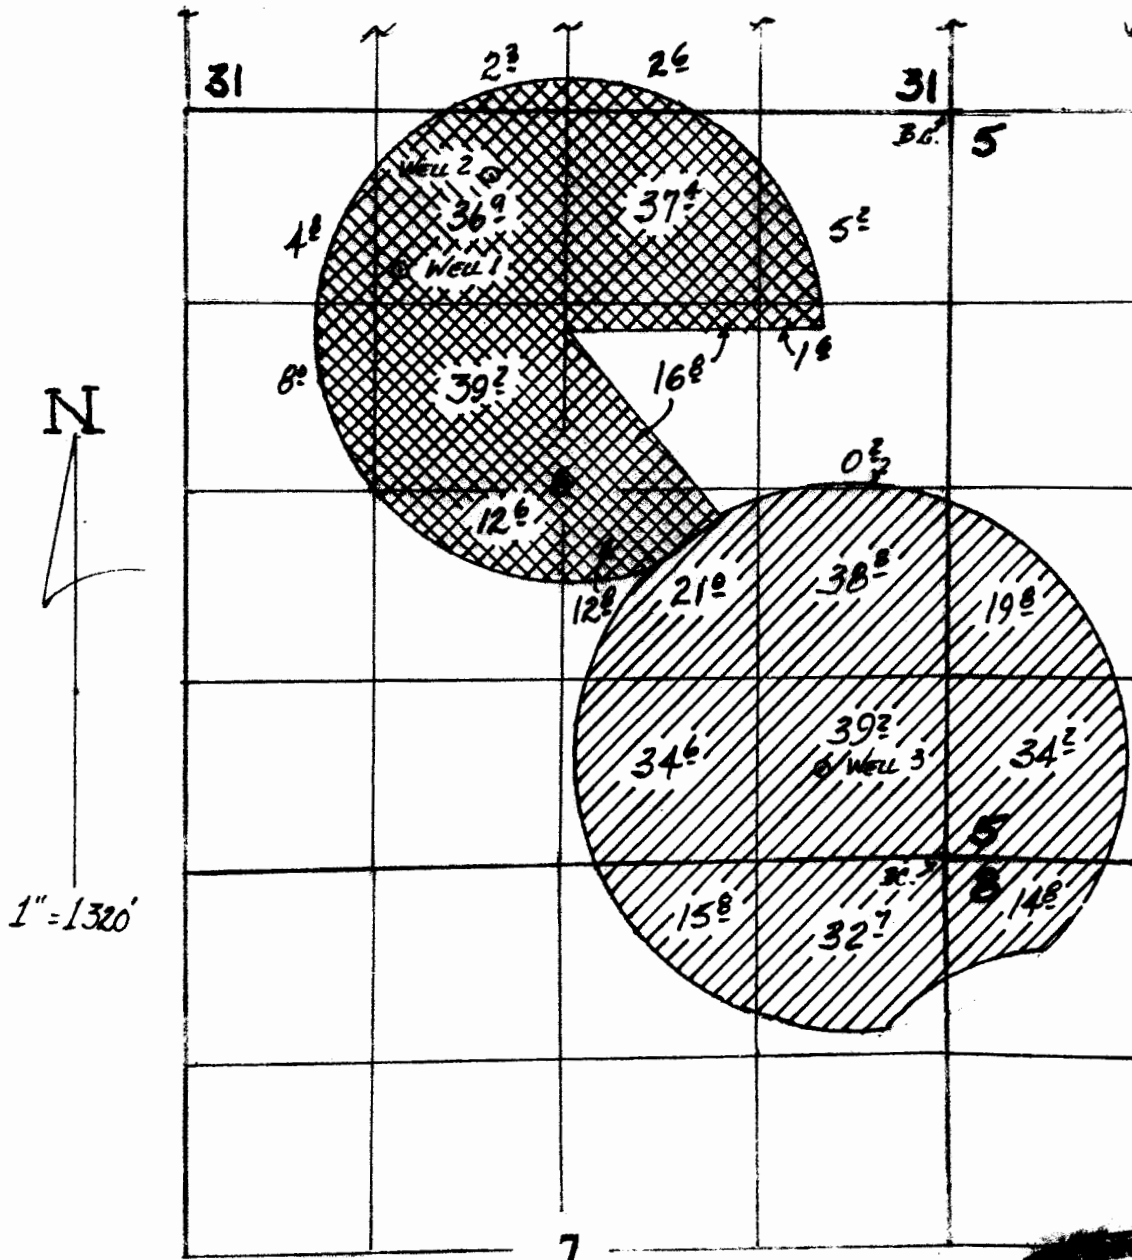

RECEIVED
APR 25 2014
OWRD

CLAIM of BENEFICIAL USE MAP
For
Shine Brothers Ranches, LLC

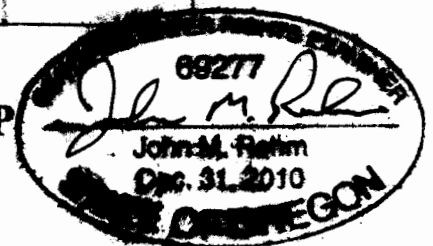

Under Application G-10476, Permit G-9646

Well Locations:

- Well 1- 1120' S. & 3780' W. from the NE Cor. Section 6; 
- Well 2- 440' S. & 3150' W. " " " " " 
- Well 3- 620' N. & 860' W. from the SE Cor. Section 6 

This map is for the purpose of identifying the location of water rights only, and is not intended to provide legal dimensions or locations of property lines.