

FINAL PROOF SURVEY MAP

T 10 S R 2 W, W.M. Section 9


prepared for: MILLER FORESTS, INC.

transfers: T-8845 & T-9922

RECEIVED


DEC 08 2006

**WATER RESOURCES DEPT
SALEM, OREGON**

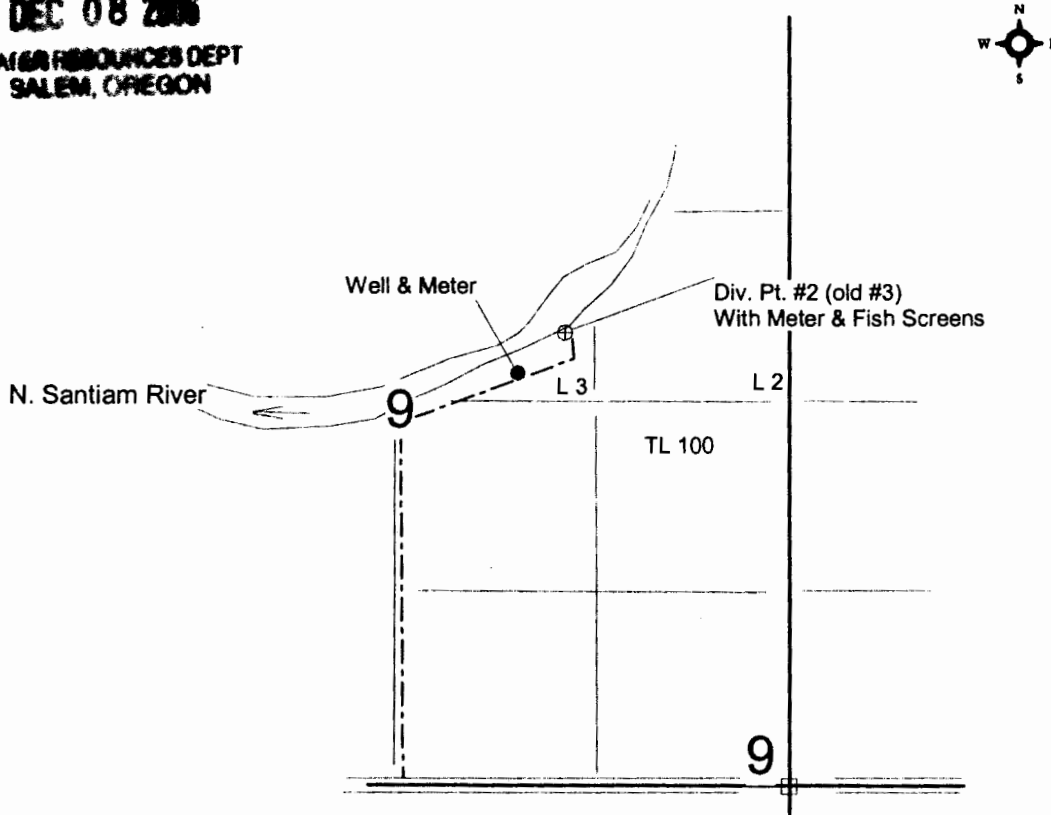

Div. Pt. #2 (old #3): 3150' N & 1540' W
Well: 2750' N & 1760' W
both from the SE corner Section 9

4" = 1 mile

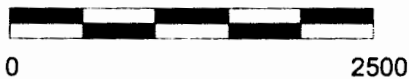


This map is not intended to provide legal dimensions or locations of property ownership lines.



RENEWAL DATE: 6-30-2007

T. 10S. R. 2W. W.M.

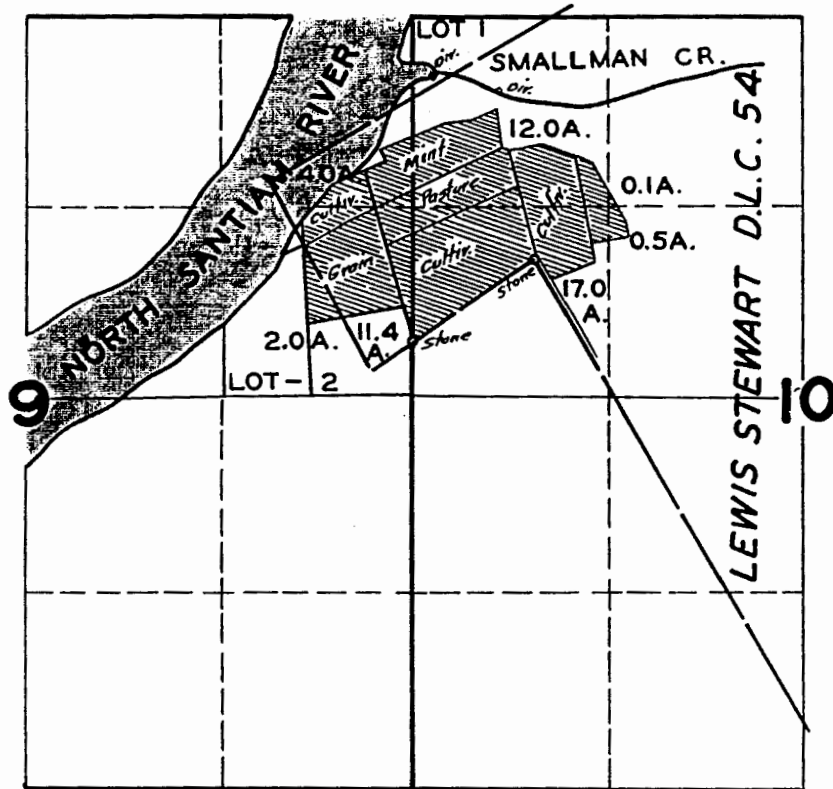

FINAL PROOF SURVEY UNDER

Application No. 20866 Permit No. 16343

IN NAME OF

KENNETH W. CUNNINGHAM

Surveyed MAY 8, 1947, by JAS. E. BUNNELL