

FINAL PROOF SURVEY MAP

T 10 S R 2 W, W.M. Section 9


prepared for: MILLER FORESTS, INC.

transfers: T-8845 & T-9922

RECEIVED


DEC 08 2006

**WATER RESOURCES DEPT
SALEM, OREGON**

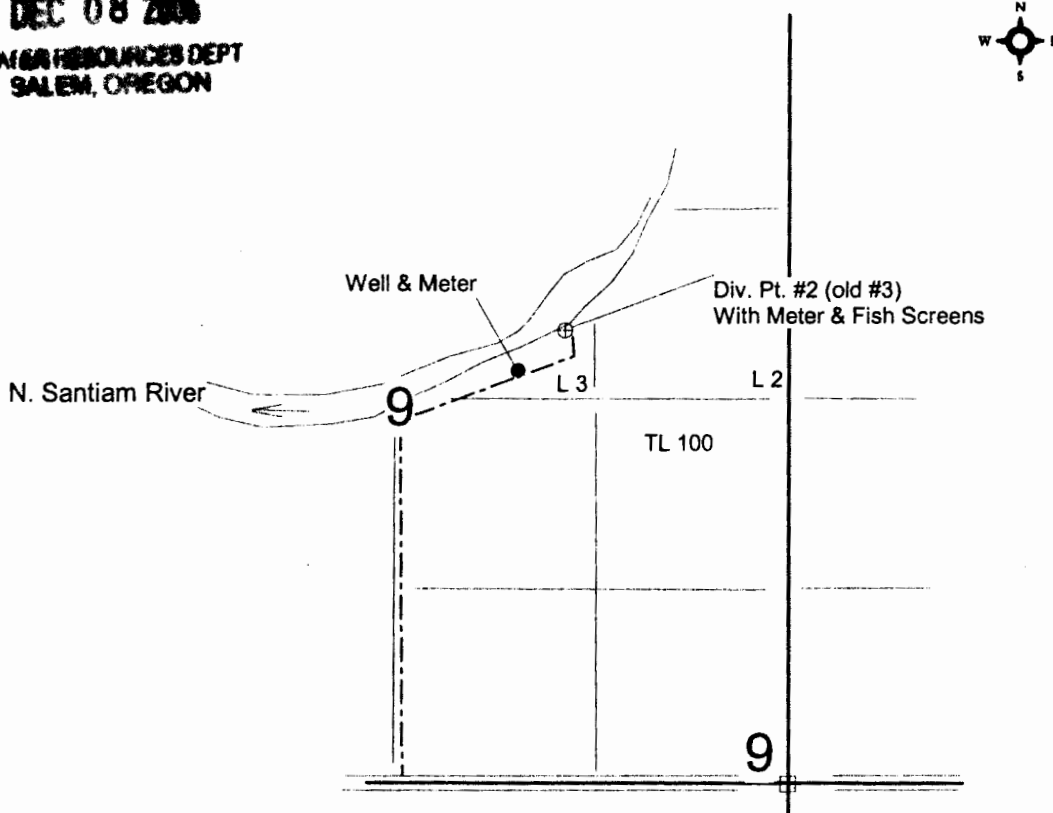

Div. Pt. #2 (old #3): 3150' N & 1540' W
Well: 2750' N & 1760' W
both from the SE corner Section 9

4" = 1 mile

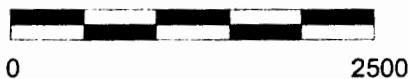




This map is not intended to provide legal dimensions or locations of property ownership lines.



RENEWAL DATE: 6-30-2007

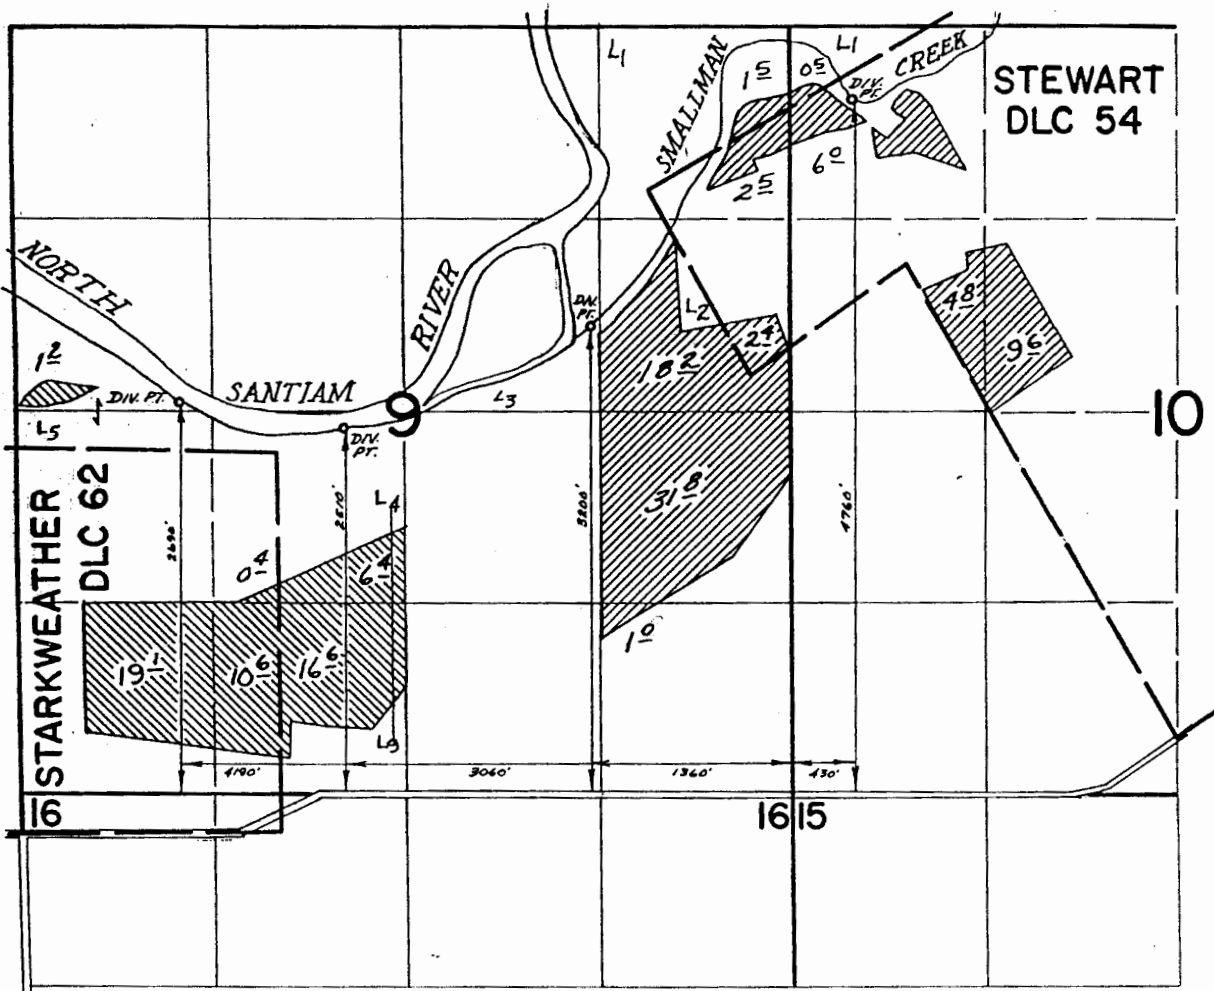T.10S., R.2W., W.M.



-  NORTH SANTIAM RIVER
-  SMALLMAN CREEK

FINAL PROOF SURVEY UNDER

Application No. 48117 Permit No. 36132
IN NAME OF

KENNETH AND MYRTLE ELLIS

Surveyed Nov. 4 1974, by D. Norby