


file copy - do not remove 8/30/02

T6N, R35E, S34 WM

PRUNEDALE ROAD

BURRIS LANE

HUDSON BAY DITCH

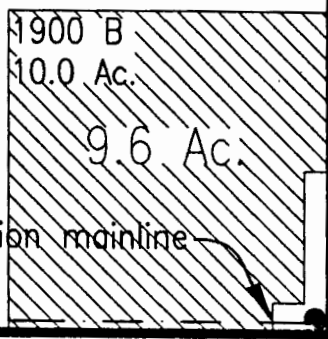

3-inch PVC irrigation mainline

CHAMBERLIN LANE

Supplemental POA

RECEIVED

AUG 19 2002

WATER RESOURCES DEPT.
SALEM, OREGON

34




SCALE
1 inch = 400 feet
0 400

- POA is well located 1335 feet west and 30 feet north from center of Section 34. Well pump is 7.5 HP submersible co-located with domestic pump in 12-inch casing. Static lift estimated at 70 feet. Water is conveyed via 3-inch pvc buried mainline along south boundary of property. Use of well is supplemental to surface water source supplied by Hudson Bay Irrigation District under Certificate 52576.



Water applied for irrigation of wine grapes on 9.6 acres in SW 1/4 of the NW 1/4 of Section 34. Vineyard divided into three irrigation zones with a total of 10,545 pressure compensating emitters (0.5 GPH) on 3/8-inch drip tubing.

The purpose of this map is to identify the location of a water right. It is not intended to provide information relative to the location of property ownership boundary lines.

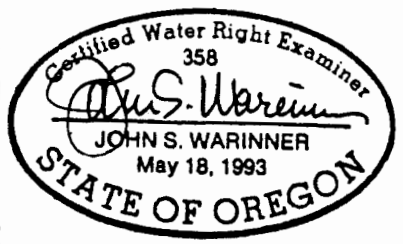

Fountainhead Irrigation, Inc.

PO Box 2197 Walla Walla, WA 99362
Ph (509) 529-2646 Fax (509) 522-5251

Project Name:
Cayuse Vineyards
Milton-Freewater, OR

Date:
09 JULY 02

FINAL PROOF SURVEY

Application No. G-14831
Permit No. G-13656

IN THE NAME OF
Cayuse Vineyards
PO Box 1602
Walla Walla, WA 99362

Surveyed 04 MAR 02 by
John Warinner, CWRE