


T. 4 S., R. 48 E., W.M.

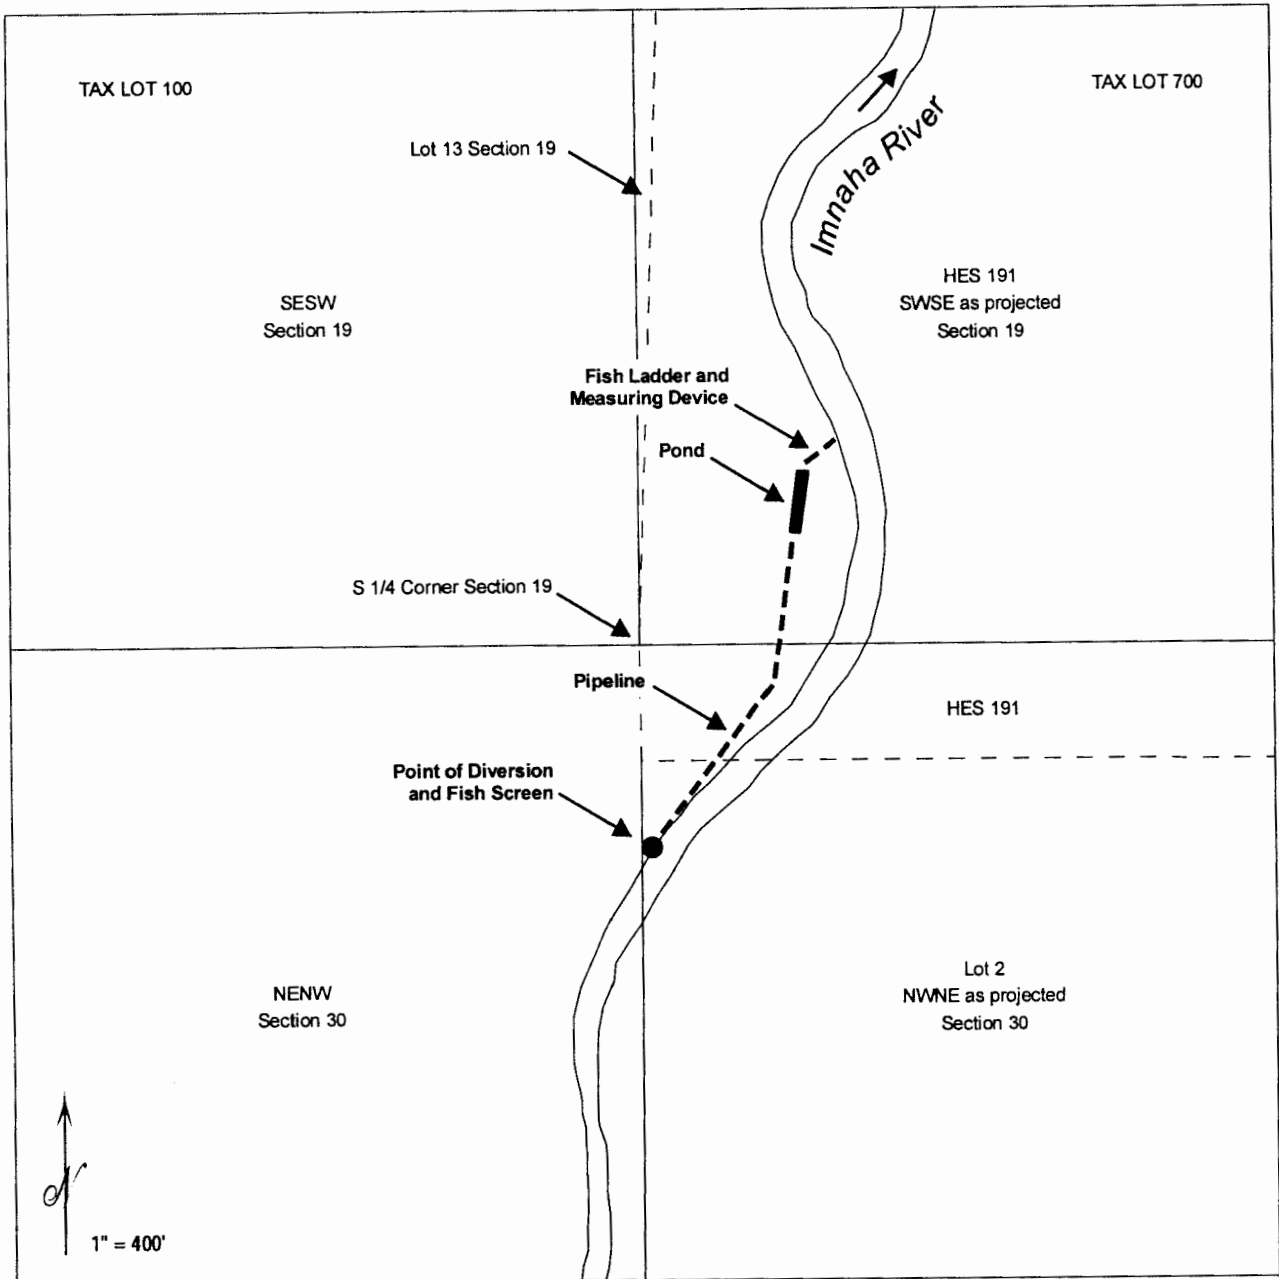

Final Proof Survey


Application S 83381, Permit S 53776

In Name of U.S. Fish and Wildlife Service

Place of Use: SW 1/4 SE 1/4 Section 19, T4S, R48E, W.M.
Point of Diversion: South 426 feet, East 20 feet from south 1/4 corner Section 19, T4S, R48E, W.M.

THE PURPOSE OF THIS MAP IS TO IDENTIFY THE LOCATION OF THE WATER RIGHT. IT IS NOT INTENDED TO PROVIDE INFORMATION RELATIVE TO THE LOCATION OF PROPERTY OWNERSHIP BOUNDARY LINES.

LKN_FPS_NewDesign.MXD, 6/12/08

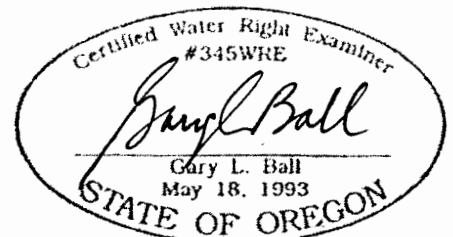

RENEWAL DATE: 12/31/09