

RECEIVED
OCT 16 1968
STATE ENGINEER
SALEM OREGON


RECEIVED
AUG 9 1968
STATE ENGINEER
SALEM OREGON

LEGAL DISCRPTION
OF PROPERTY

LOT # 6 -

THE N. $\frac{1}{2}$ of NE $\frac{1}{4}$
THE SE $\frac{1}{4}$ of NE $\frac{1}{4}$
of SET. 12 - 23 S. R. 10 W

Resort
↓
○

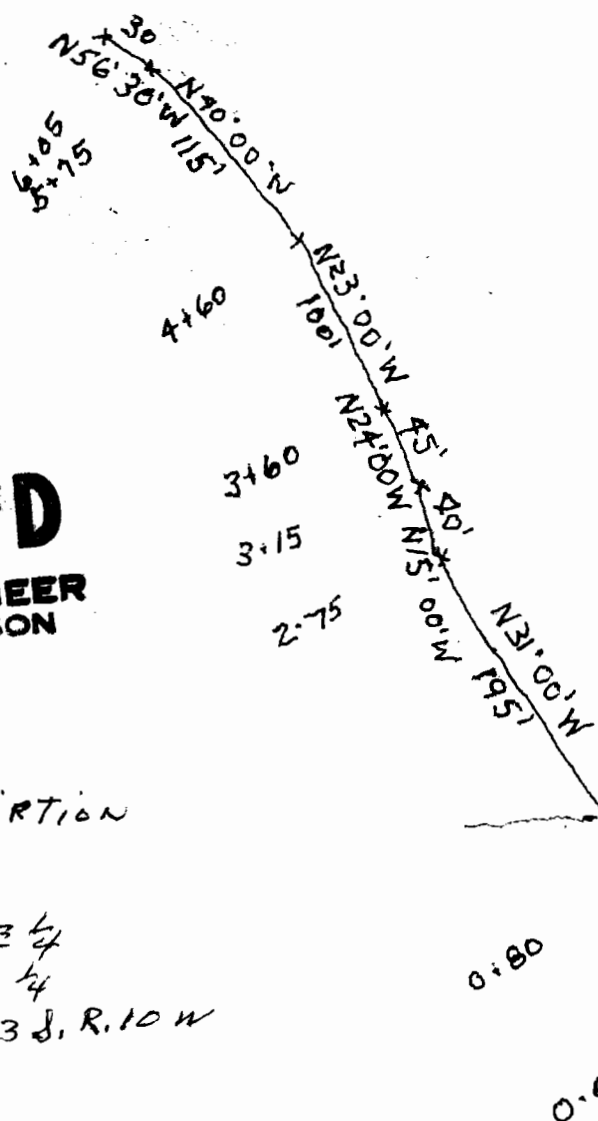


Application No. 45278
Permit No.

RECEIVED

OCT-16 1968

STATE ENGINEER
SALEM OREGON

Application No. 45278
Permit No. 33811


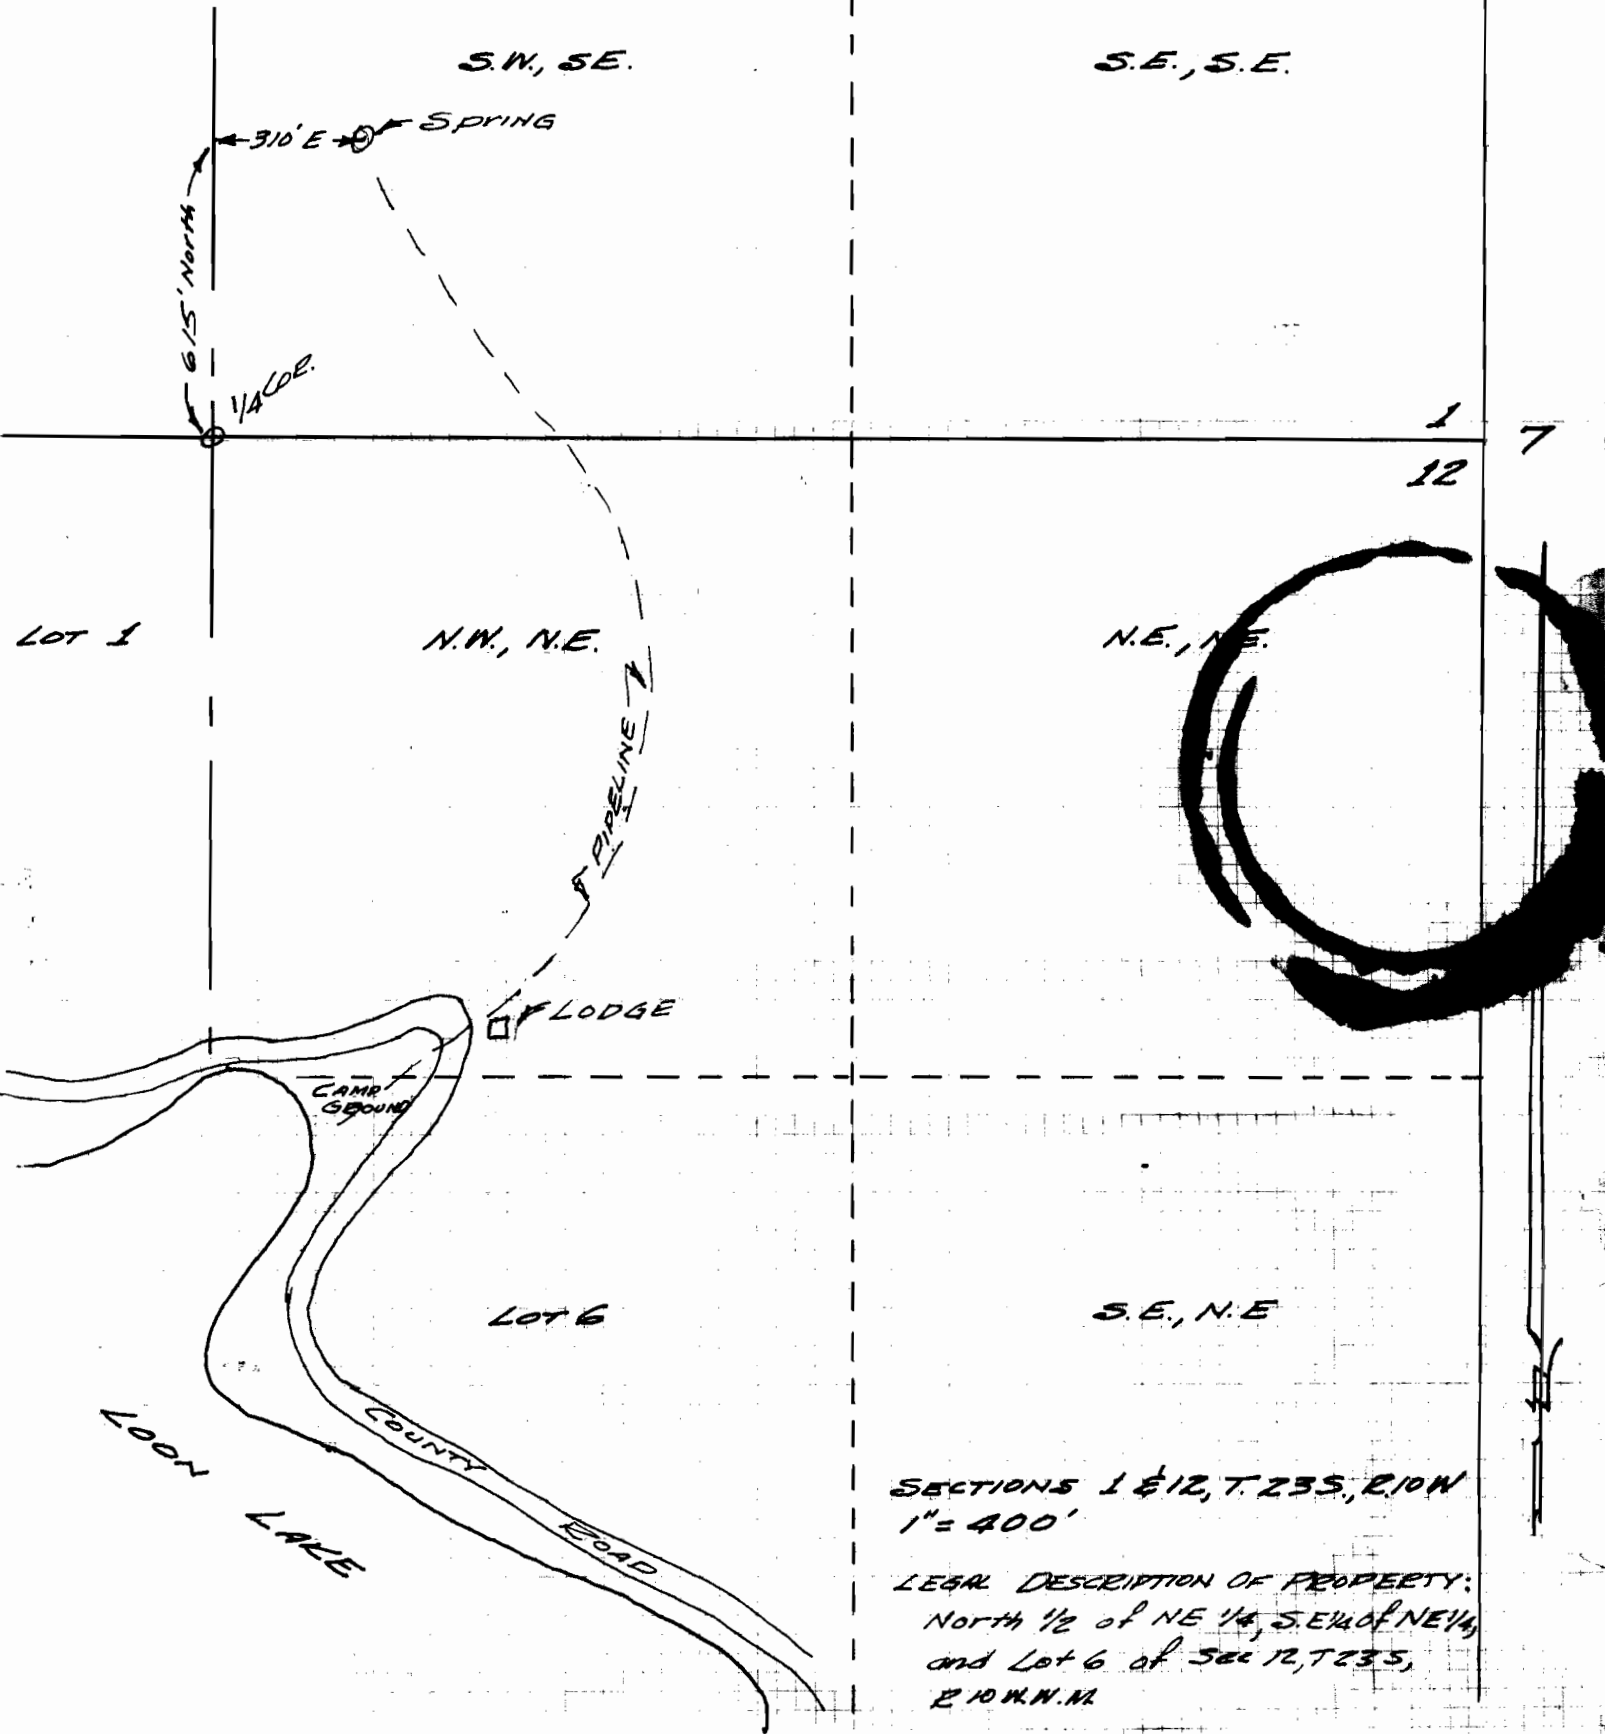


SECTIONS 1 & 12, T. 23 S., R. 10 W.
1" = 400'

LEGAL DESCRIPTION OF PROPERTY:
North 1/2 of NE 1/4, S.E. 1/4 of NE 1/4,
and Lot 6 of Sec 12, T. 23 S.,
R. 10 W. N.M.

Map to Accompany Application For Transfer
In the Name of Loon Lake Lodge & RV Resort, LLC

T. 23 S., R. 10 W., WM

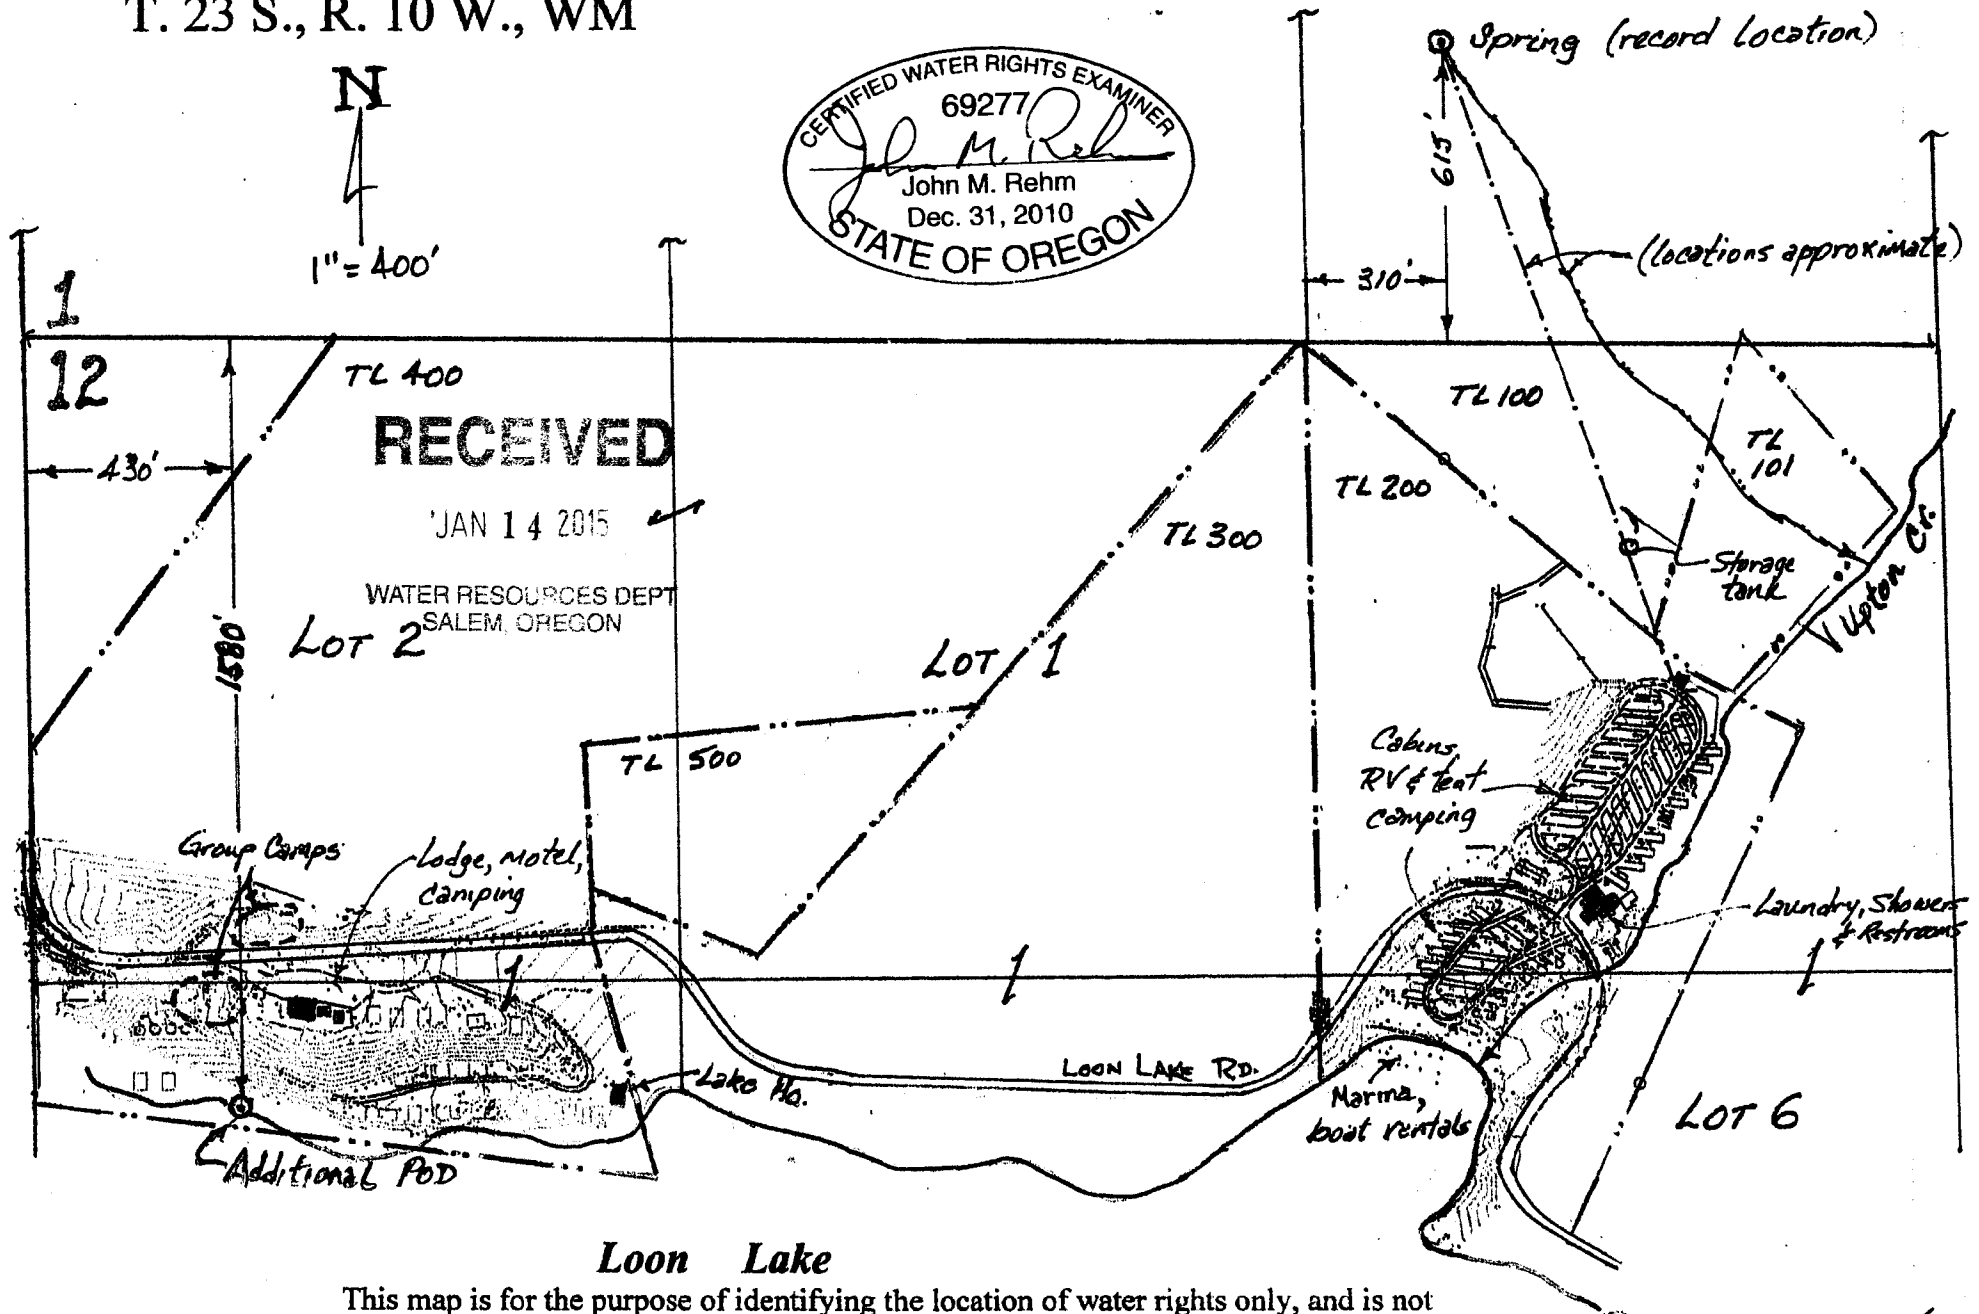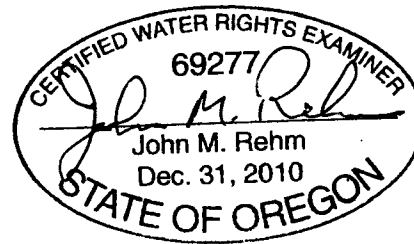

This map is for the purpose of identifying the location of water rights only, and is not
Intended to provide legal dimensions or locations of property lines.