

CLAIM OF BENEFICIAL USE FINAL PROOF MAP

Located in portions of NW 1/4 NW 1/4 of Section 33
and portions of SW 1/4 SW 1/4 of Section 28
Township 29 South, Range 10 West, W.M.

Application S-73079 Permit 52618

RECEIVED


OCT 18 1999

Prepared For: George Clarno Jr.
Prepared By: Dennis Goude
Date Prepared: September 17, 1999

Note:
P.O.D. #1 is a concrete dam
28' X 5' X 6.5".
The P.O.D. is located 690'
North and 484' East of
the S 1/4 corner of Sec. 28


Note:
P.O.D. #2 is an earthen dam
40' X 10' X 8'. The P.O.D. is
located 177' South and 1435'
West of the N 1/4 corner of Sec.33

WATER RESOURCES DEPT.
SALEM, OREGON

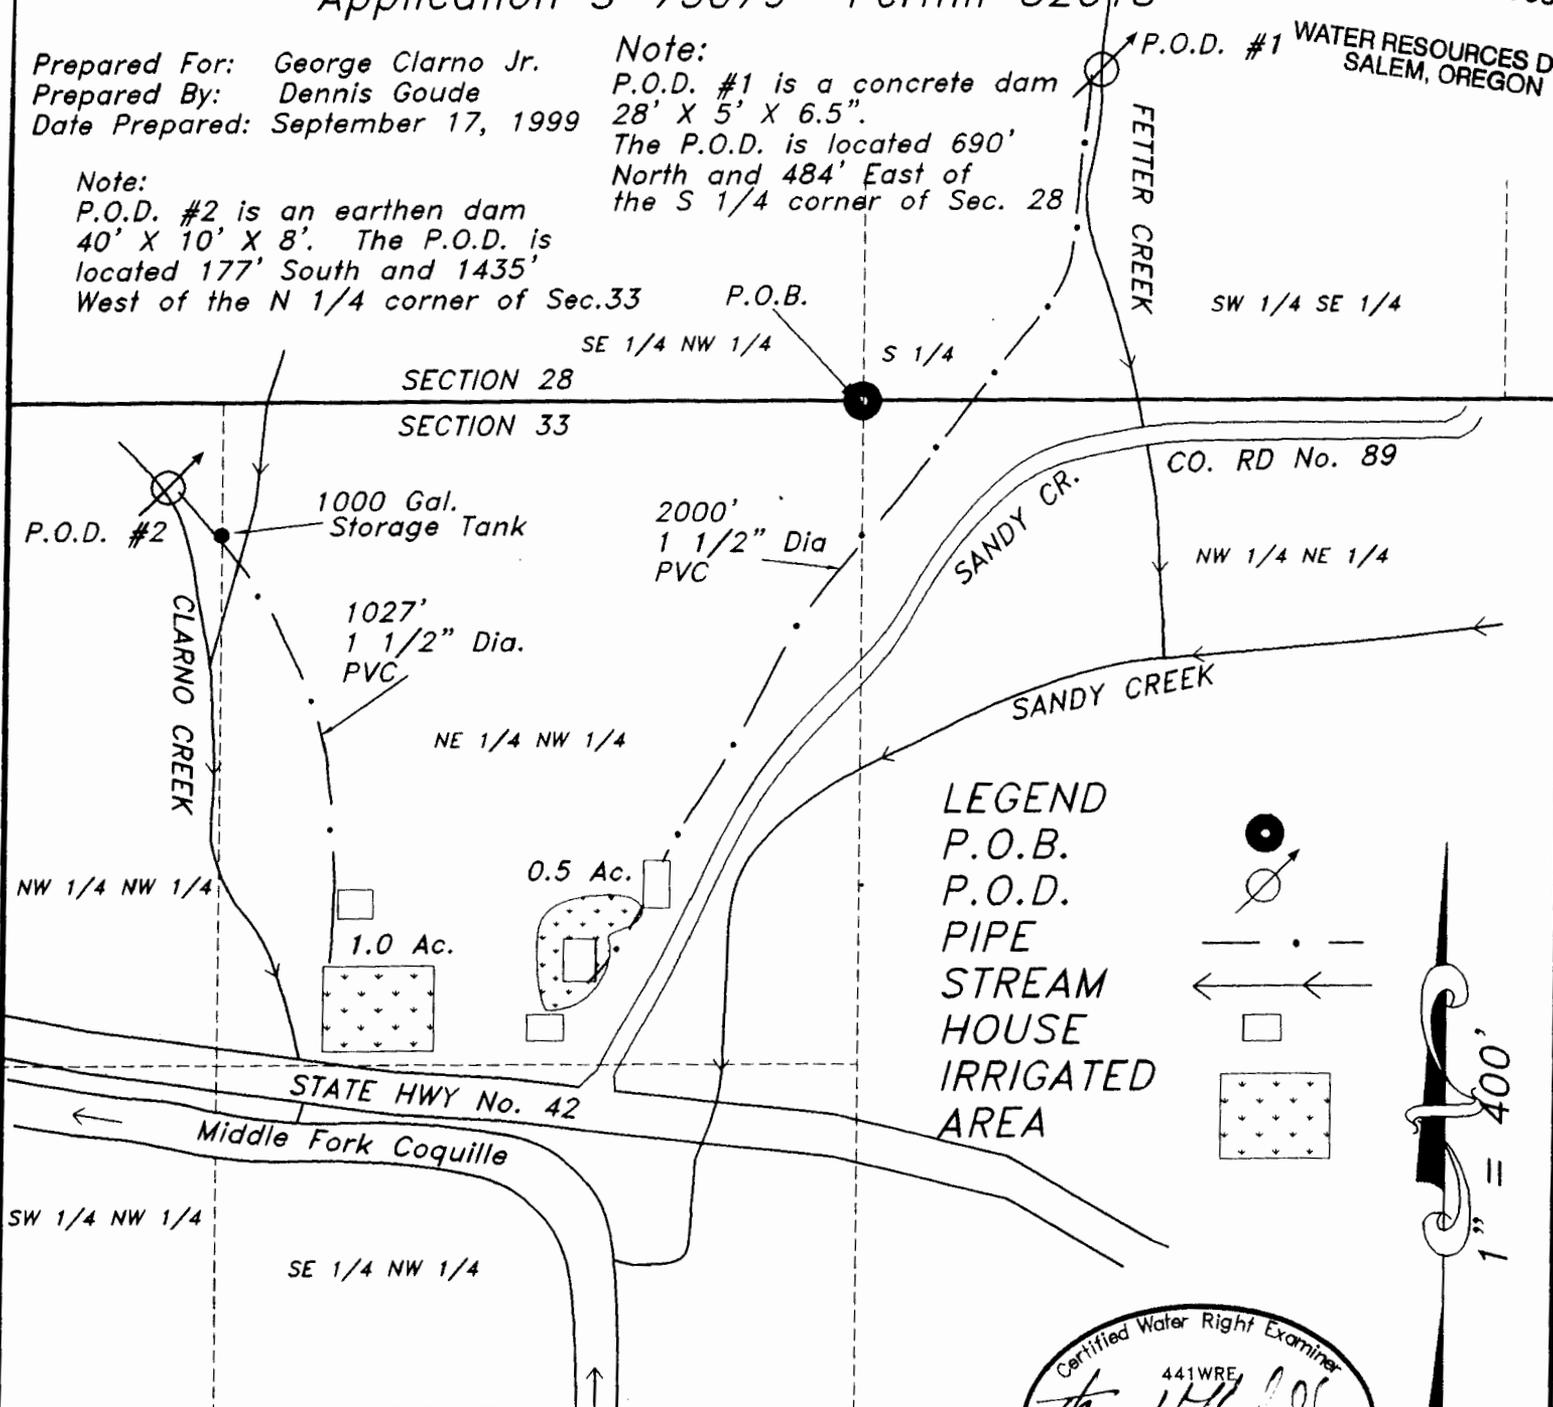

LEGEND

- P.O.B.
- P.O.D.
- PIPE
- STREAM
- HOUSE
- IRRIGATED AREA

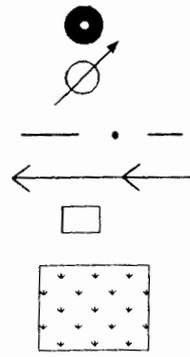

**Stuntzner Engineering
& Forestry**

ENGINEERING - LAND SURVEYING - FORESTRY
PLANNING - WATER RIGHTS

706 South 4th,
Post Office Box 118
Coos Bay, Oregon 97420

503-267-2872
503-267-0588 FAX



EXPIRES 06/30/2001

EXAMINERS DISCLAIMER STATEMENT
The preparation of this map was for the purpose of
identifying the location of the Water Right only and
has no intent to provide dimensions or location of
property ownership lines.