

962

RECEIVED BY OWRD

FEB 02 2016

SALEM, OR

Partial Perfection Claim of Beneficial Use Map Water Right in the Name of City of Rogue River

Permit S-26594, Application S-33661
Jackson County, Oregon
Township 36 South, Range 4 West (W.M.)



962


LEGEND

- Place of Use (POU)
- Point of Diversion (POD)
- Rogue River City Limits
- Donation Land Claim (DLC)
- Government Lot
- Tax Lots
- Railroad
- Watercourses
- Waterbodies

POD LOCATION DESCRIPTION

Rogue River Intake
Located 750 feet South and 10 feet West from the common corner of Sections 15, 16, 21, 22, Township 36 South, Range 4 West (W.M.)

Certified Water Rights Examiner Stamp

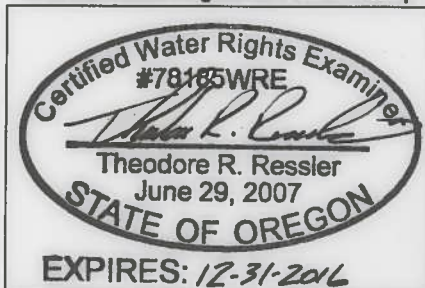

DISCLAIMER
This map was prepared for the purpose of identifying the location of a water right only and it is not intended to provide legal dimensions or location of property ownership lines.

MAP NOTES

Date: February 18, 2016
Data Sources: OWRD, Jackson Co. GIS, US BLM
Prepared By: GSI Water Solutions, Inc.

