


T.5S., R.1E., W.M.

RECEIVED
 MAY 12 2004
 WATER RESOURCES DEPT
 SALEM, OREGON

Final Proof Survey In The Name Of
Bill L. Rose
 Application #: S-85010 Permit #: 53839

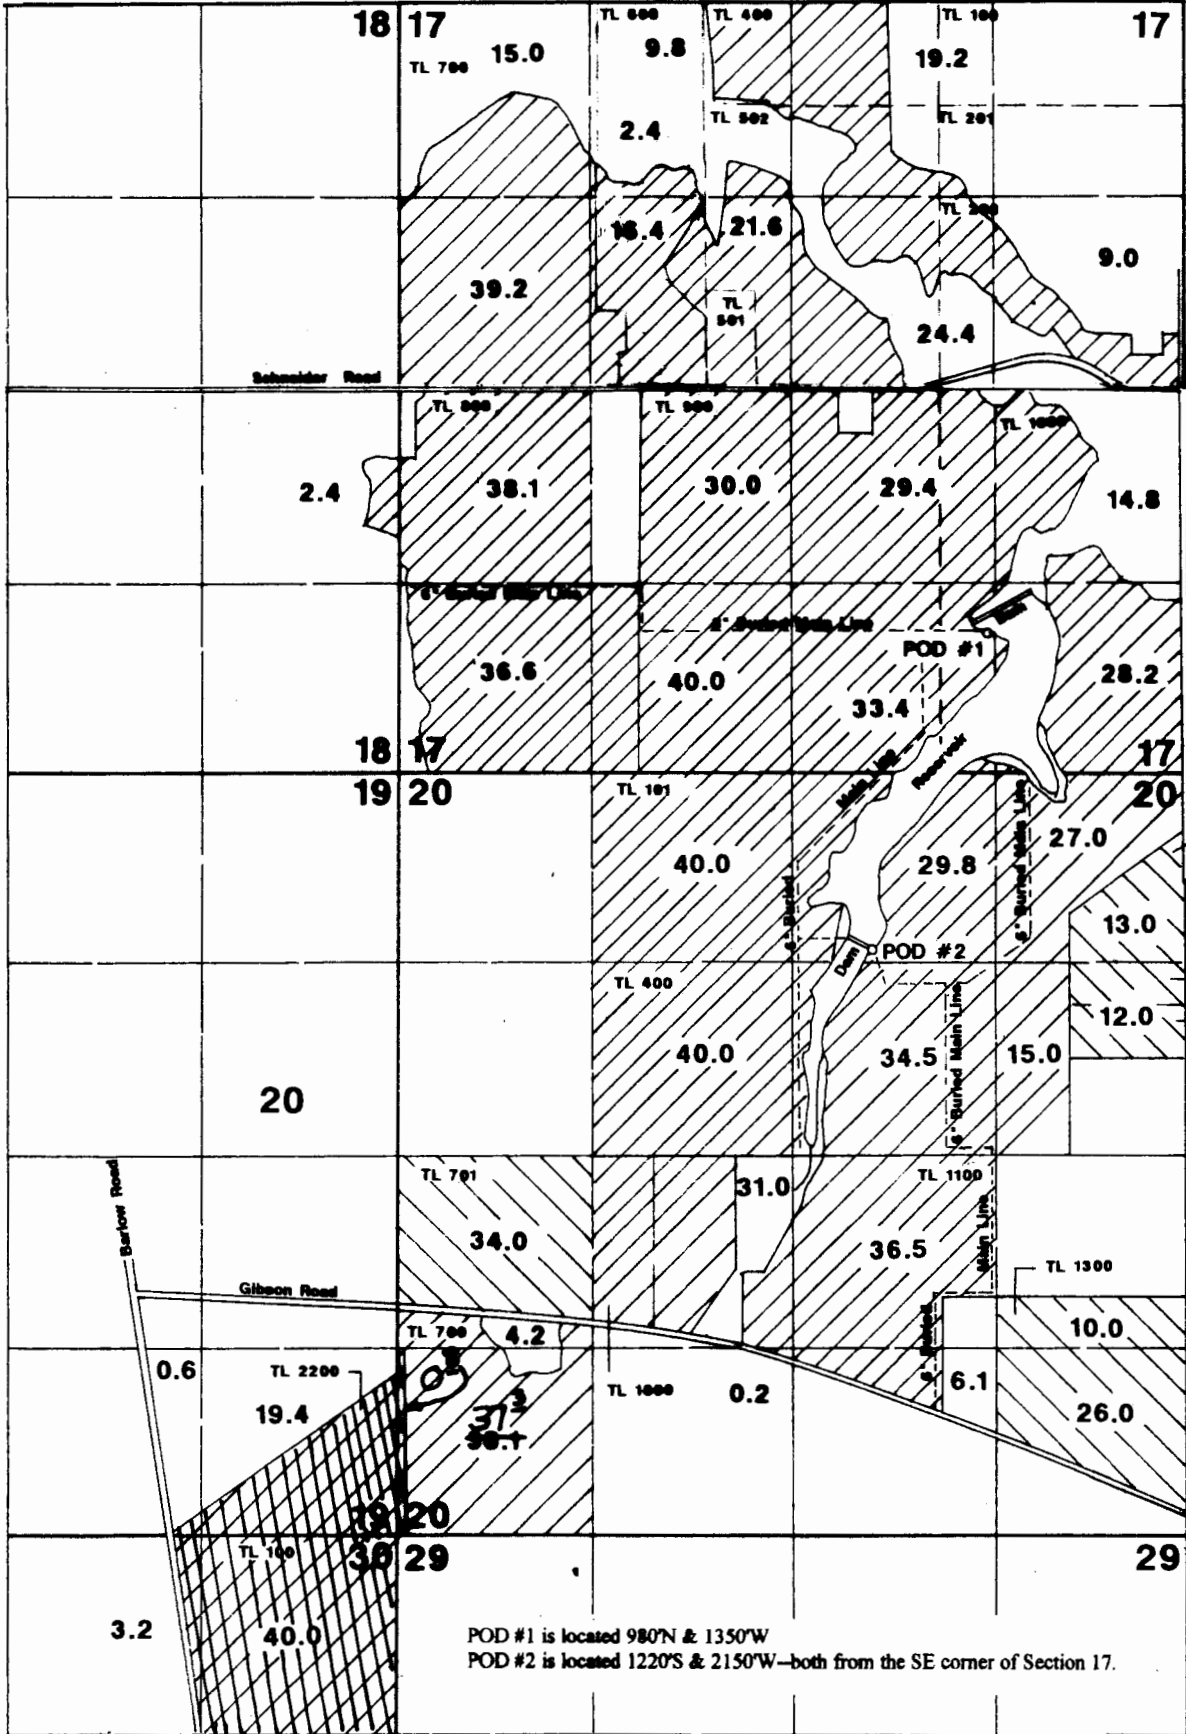

POD #1 is located 980'N & 1350'W
 POD #2 is located 1220'S & 2150'W—both from the SE corner of Section 17.

This Map Was Prepared for the Purpose of Identifying the Location of a Water Right Only and is not Intended to Provide Legal Dimensions or Location of Property Ownership Line

Surveyed on February 8, 2004 by JM Schuette

The map has been revised by WRD to reflect the water user's voluntary partial cancellation, indicated by cross-hatching, rec'd 11-27-12.

