


T.5S., R.1E., W.M

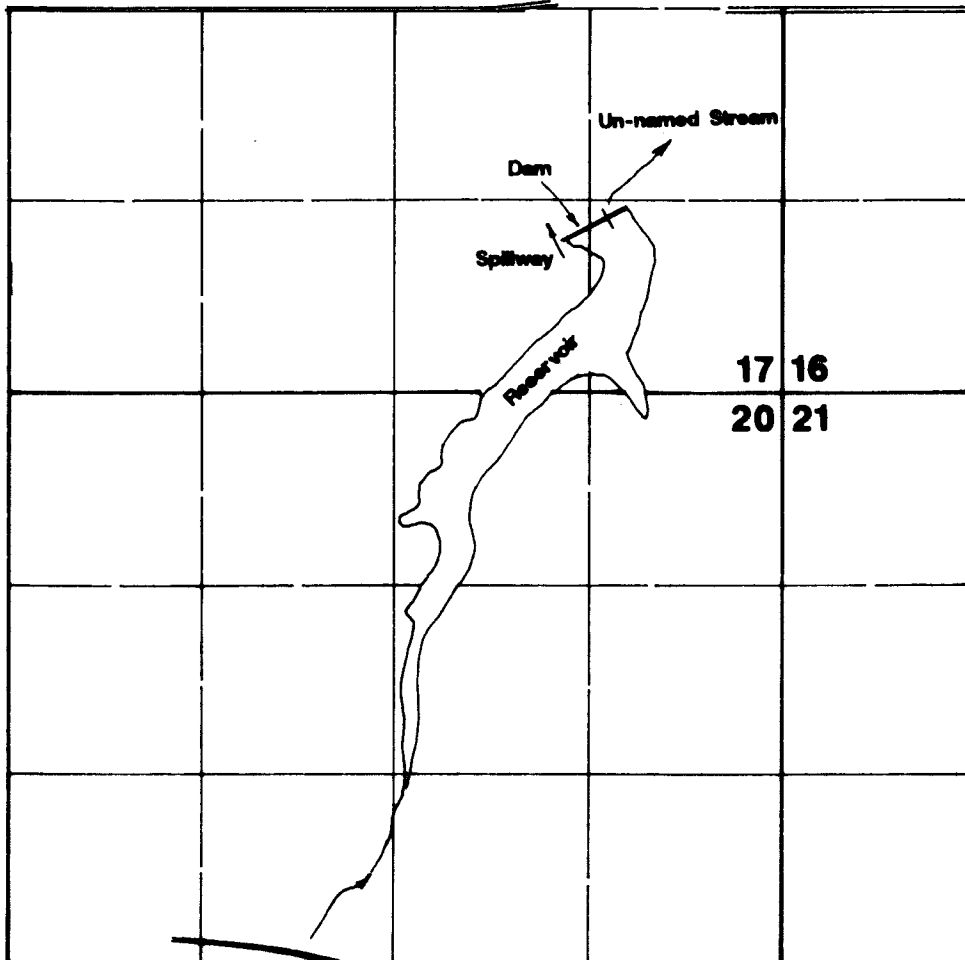

Dam is located 1220'N & 1220' from SE corner of Section 17.

Final Proof Survey

In The Name Of

Bill L. Rose

Application #: R-84680

Permit #: R-13163

Surveyed on February 8, 2004 by JM Schuette

RECEIVED

MAY 12 2004

WATER RESOURCES DEPT
SALEM, OREGON

This Map Was Prepared for the Purpose of Identifying the Location of a Water Right Only and is not Intended to Provide Legal Dimensions or Location of Property Ownership Line

