


SECTIONS 16 & 21, TWP.3 S. RANGE 16 E. W.M. SHERMAN COUNTY, OREGON

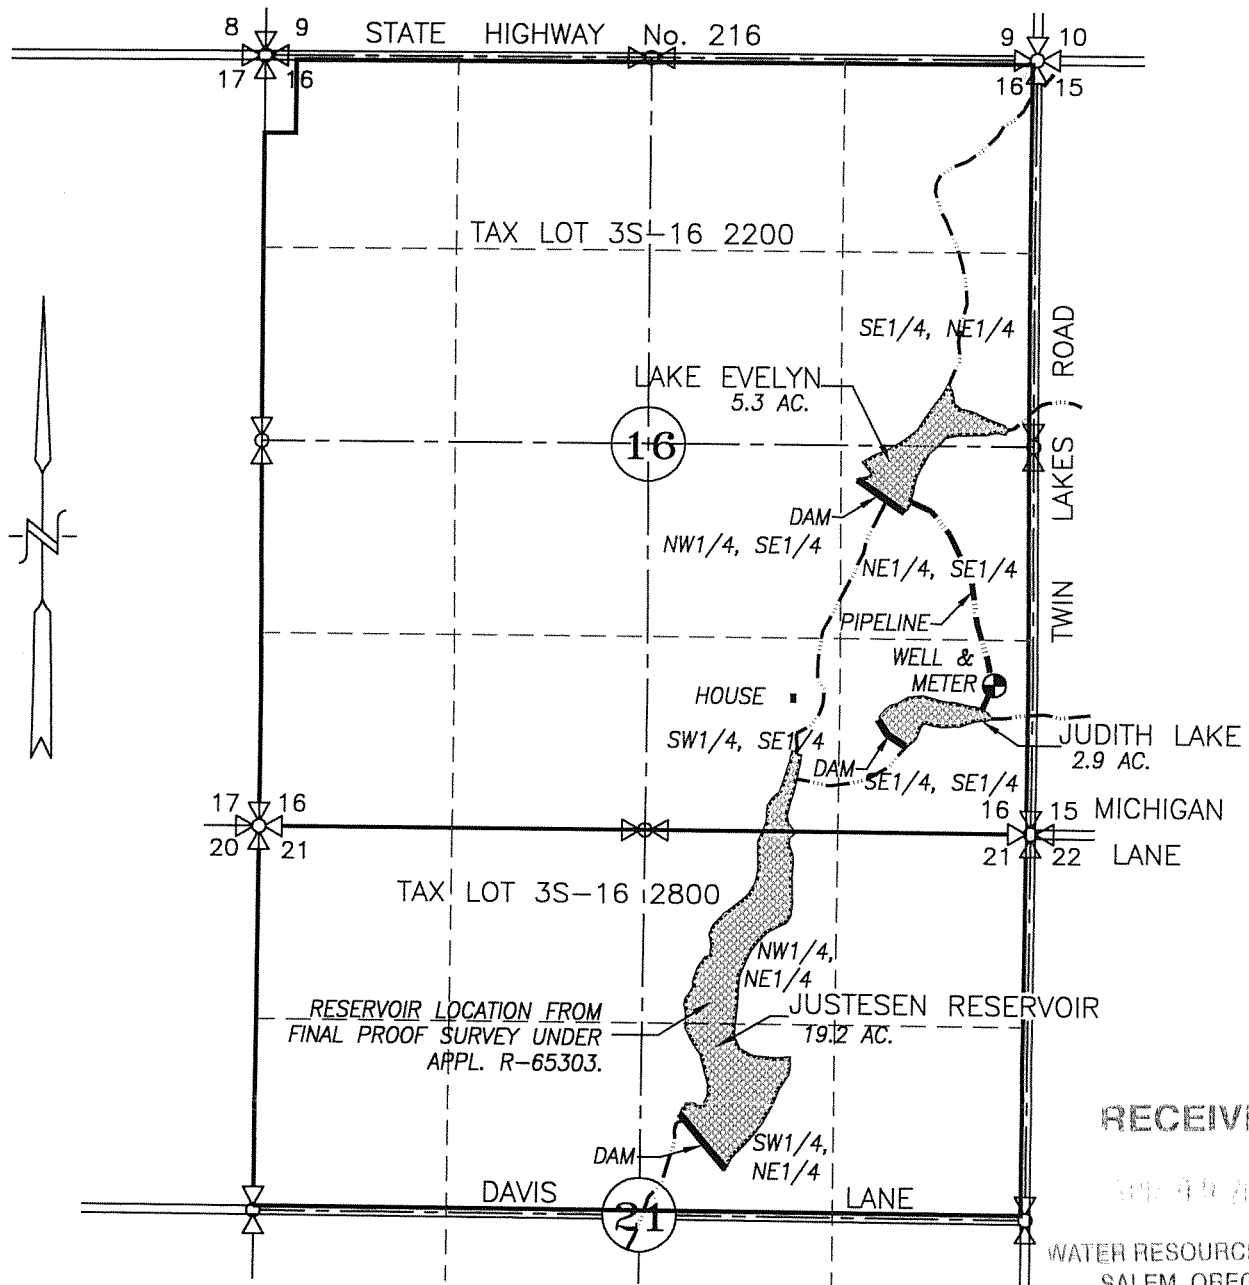

RECEIVED

WATER RESOURCES DEPT
SALEM, OREGON

WELL. 1014' N. & 263' W. OF THE SE. CORNER, SECTION 16

RESERVOIR SURFACE AREAS

4" IRRIGATION MAIN

JUSTESEN RESERVOIR: 2130' S. AND 2215' W. OF THE NE CORNER SECTION 21
JUDITH LAKE: 675' N. AND 985' W. OF THE SE CORNER SECTION 16
LAKE EVELYN: 2300' N. AND 1045' W. OF THE SE CORNER SECTION 16

CLAIM OF BENEFICIAL USE MAP

SCALE: 1" = 1320'


APPLICATION No. G-15018

PERMIT No. G-13824

IN THE NAME OF:

JUSTESEN RANCHES

DATE: FEBRUARY 26, 2009

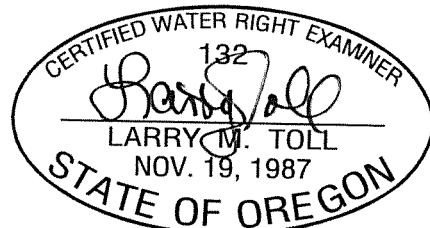

EXPIRES: 06/30/2010

BY: **TENNESON ENGINEERING CORP.**

3313 W. 2nd. STREET, SUITE 100
THE DALLES, OREGON. 97058
PH. (541) 296-9177
FAX (541) 296-6657



NOTE:

"THIS MAP IS NOT INTENDED TO
PROVIDE DIMENSIONS OR LOCATIONS
OF PROPERTY OWNERSHIP LINES."

W.O. #11132wr