
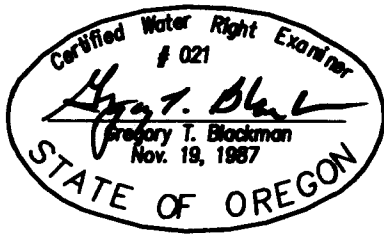


SUPERSEDING

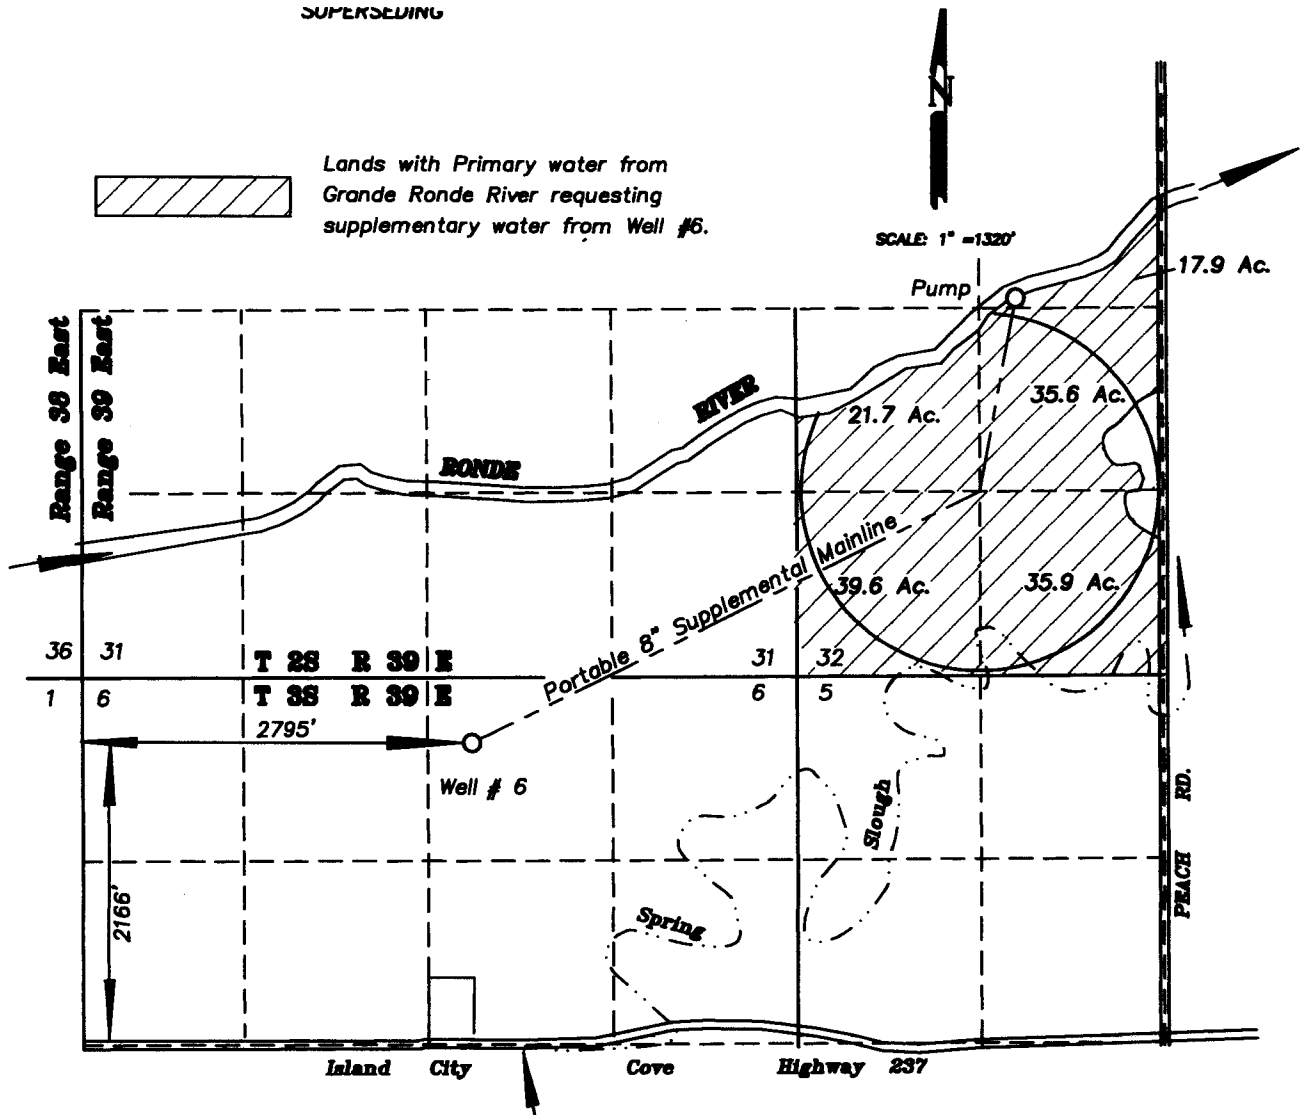

SUPERSEDING
**FINAL PROOF SURVEY
 OF SUPPLEMENTAL WATER RIGHTS
 FROM WELL # 6**

FOR
 Donald T. McCabe &
 William A. Delashmutt
 BY
 BAGETT- GRIFFITH & BLACKMAN
 2006 ADAMS AVENUE
 LAGRANDE, OREGON 97850

February 3, 2016

APPLICATION NO. G- 14357

NOTE: The preparation of this map was for the purpose of identifying the location of the proposed water right and has no intent to provide dimensions or location of property ownership lines. Location information shown hereon was furnished by the applicant.

RECEIVED BY OWRD PERMIT NUMBER G- 13255

FEB 08 2016

SALEM, OR