


T. 27 S., R. 32 E., W.M.

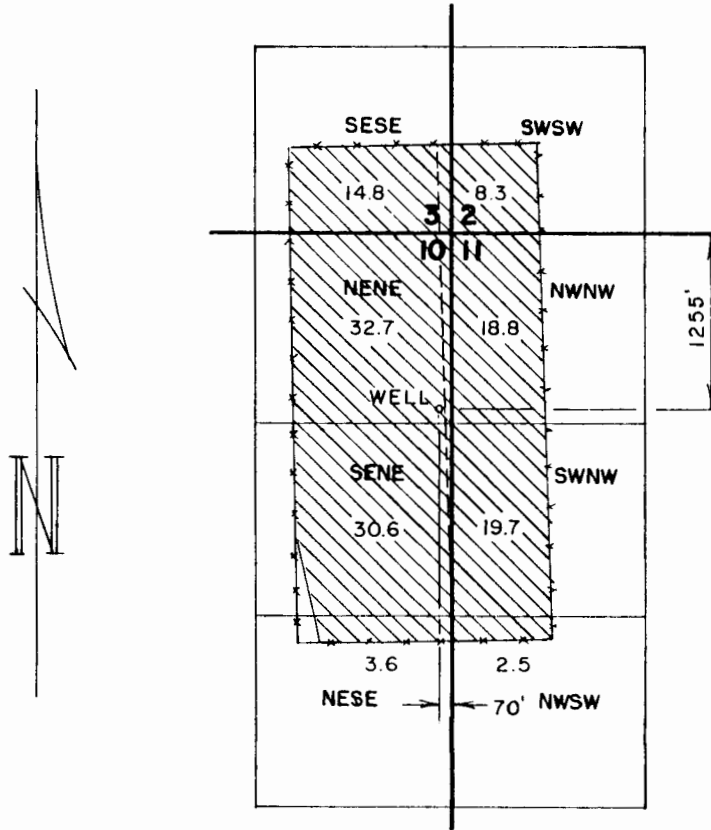

THE PURPOSE OF THIS MAP IS TO IDENTIFY THE LOCATION OF THE WATER RIGHT. IT IS NOT INTENDED TO PROVIDE INFORMATION RELATIVE TO THE LOCATION OF PROPERTY OWNERSHIP.

RECEIVED

FINAL PROOF SURVEY

UNDER APPLICATION G-12928
PERMIT G-12262

IN THE NAME OF
FRED H. & BETTY R.
BRIGGS

Scale: 4" = 1 MILE

Date: NOV. 2003

Job: 1393 A

Dsn:

Drn: CHRIS


Ckd:



M. A. PALMER & SONS, INC.
ENGINEERING & SURVEYING
254 N. Alder - Box 61
Burns, Oregon 97720

Sht. No.

of 1

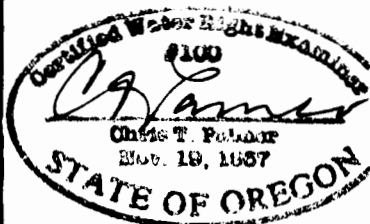

RENEW 1-1-2005