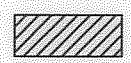


10F2
COBU MAP # 977



Section 31, T23S, R38E, W.M.,
Section 1, T24S, R37E, W.M.,
Section 6, T24S, R38E, W.M.,
Malheur County, Oregon

Canceled Certificate 40802
Transfer T-9918
CLAIM OF BENEFICIAL USE MAP
Second Oregon LLC

EXPLANATION

-  PLACE OF USE
PRIMARY IRRIGATION (68.8 ACRES)
PRIORITY: 4/12/1960
-  PLACE OF USE
SUPPLEMENTAL IRRIGATION (12.2 ACRES)
PRIORITY: 4/12/1960
-  POINT OF DIVERSION (POD)
-  PIPELINE
-  PRIMARY ACRES
SUPPLEMENTAL ACRES

- POD 1 LOCATED: 2820 FT N AND 4030 FT E FROM THE SW CORNER OF SECTION 32
- POD 4 LOCATED: 160 FT N AND 2270 FT E FROM THE SW CORNER OF SECTION 31
- POD 5 LOCATED: 1640 FT S AND 850 FT E FROM THE SW CORNER OF SECTION 31
- POD 6 LOCATED: 2350 FT S AND 1260 FT W FROM THE SW CORNER OF SECTION 31

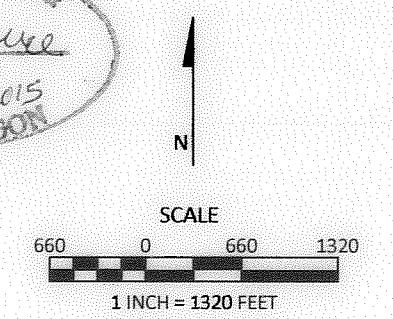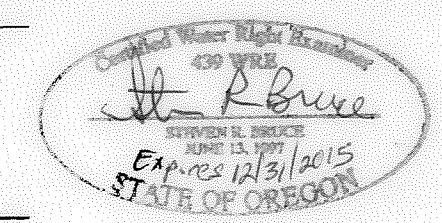

September 22, 2015

This map is not intended to provide legal
dimensions or locations of property
ownership lines

Figure 1

SKOOKUM
WATER ASSOCIATES INC

P.O. BOX 80174
PORTLAND, OR 97280
(503) 319-8926

977

977 2 of 2
COBU MAP #



Section 31, T23S, R38E, W.M.,
Section 1, T24S, R37E, W.M.,
Sections 6 & 7, T24S, R38E, W.M.,
Malheur County, Oregon

Canceled Certificate 82430
Transfer T-9918
CLAIM OF BENEFICIAL USE MAP
Second Oregon LLC

EXPLANATION

- PLACE OF USE
PRIMARY FLOOD IRRIGATION (8.8 ACRES)
PRIORITY: 10/18/1977
- PLACE OF USE
PRIMARY IRRIGATION (30.0 ACRES)
PRIORITY: 10/18/1977
- PLACE OF USE
SUPPLEMENTAL IRRIGATION (54.3 ACRES)
PRIORITY: 10/18/1977
- POINT OF DIVERSION (POD)
- PIPELINE
- PRIMARY ACRES
SUPPLEMENTAL ACRES

POD 1 LOCATED: 2820 FT N AND 4030 FT E FROM THE SW CORNER OF SECTION 32
POD 4 LOCATED: 160 FT N AND 2270 FT E FROM THE SW CORNER OF SECTION 31
POD 5 LOCATED: 1640 FT S AND 850 FT E FROM THE SW CORNER OF SECTION 31
POD 6 LOCATED: 2350 FT S AND 1260 FT W FROM THE SW CORNER OF SECTION 31

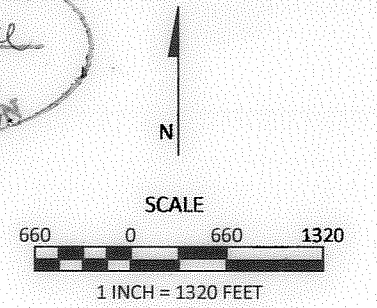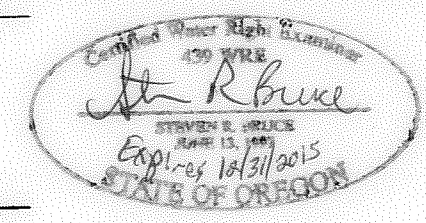


September 22, 2015

This map is not intended to provide legal
dimensions or locations of property
ownership lines

Figure 2

SKOOKUM
WATER ASSOCIATES INC

P.O. BOX 80174
PORTLAND, OR 97280
(503) 319-8926

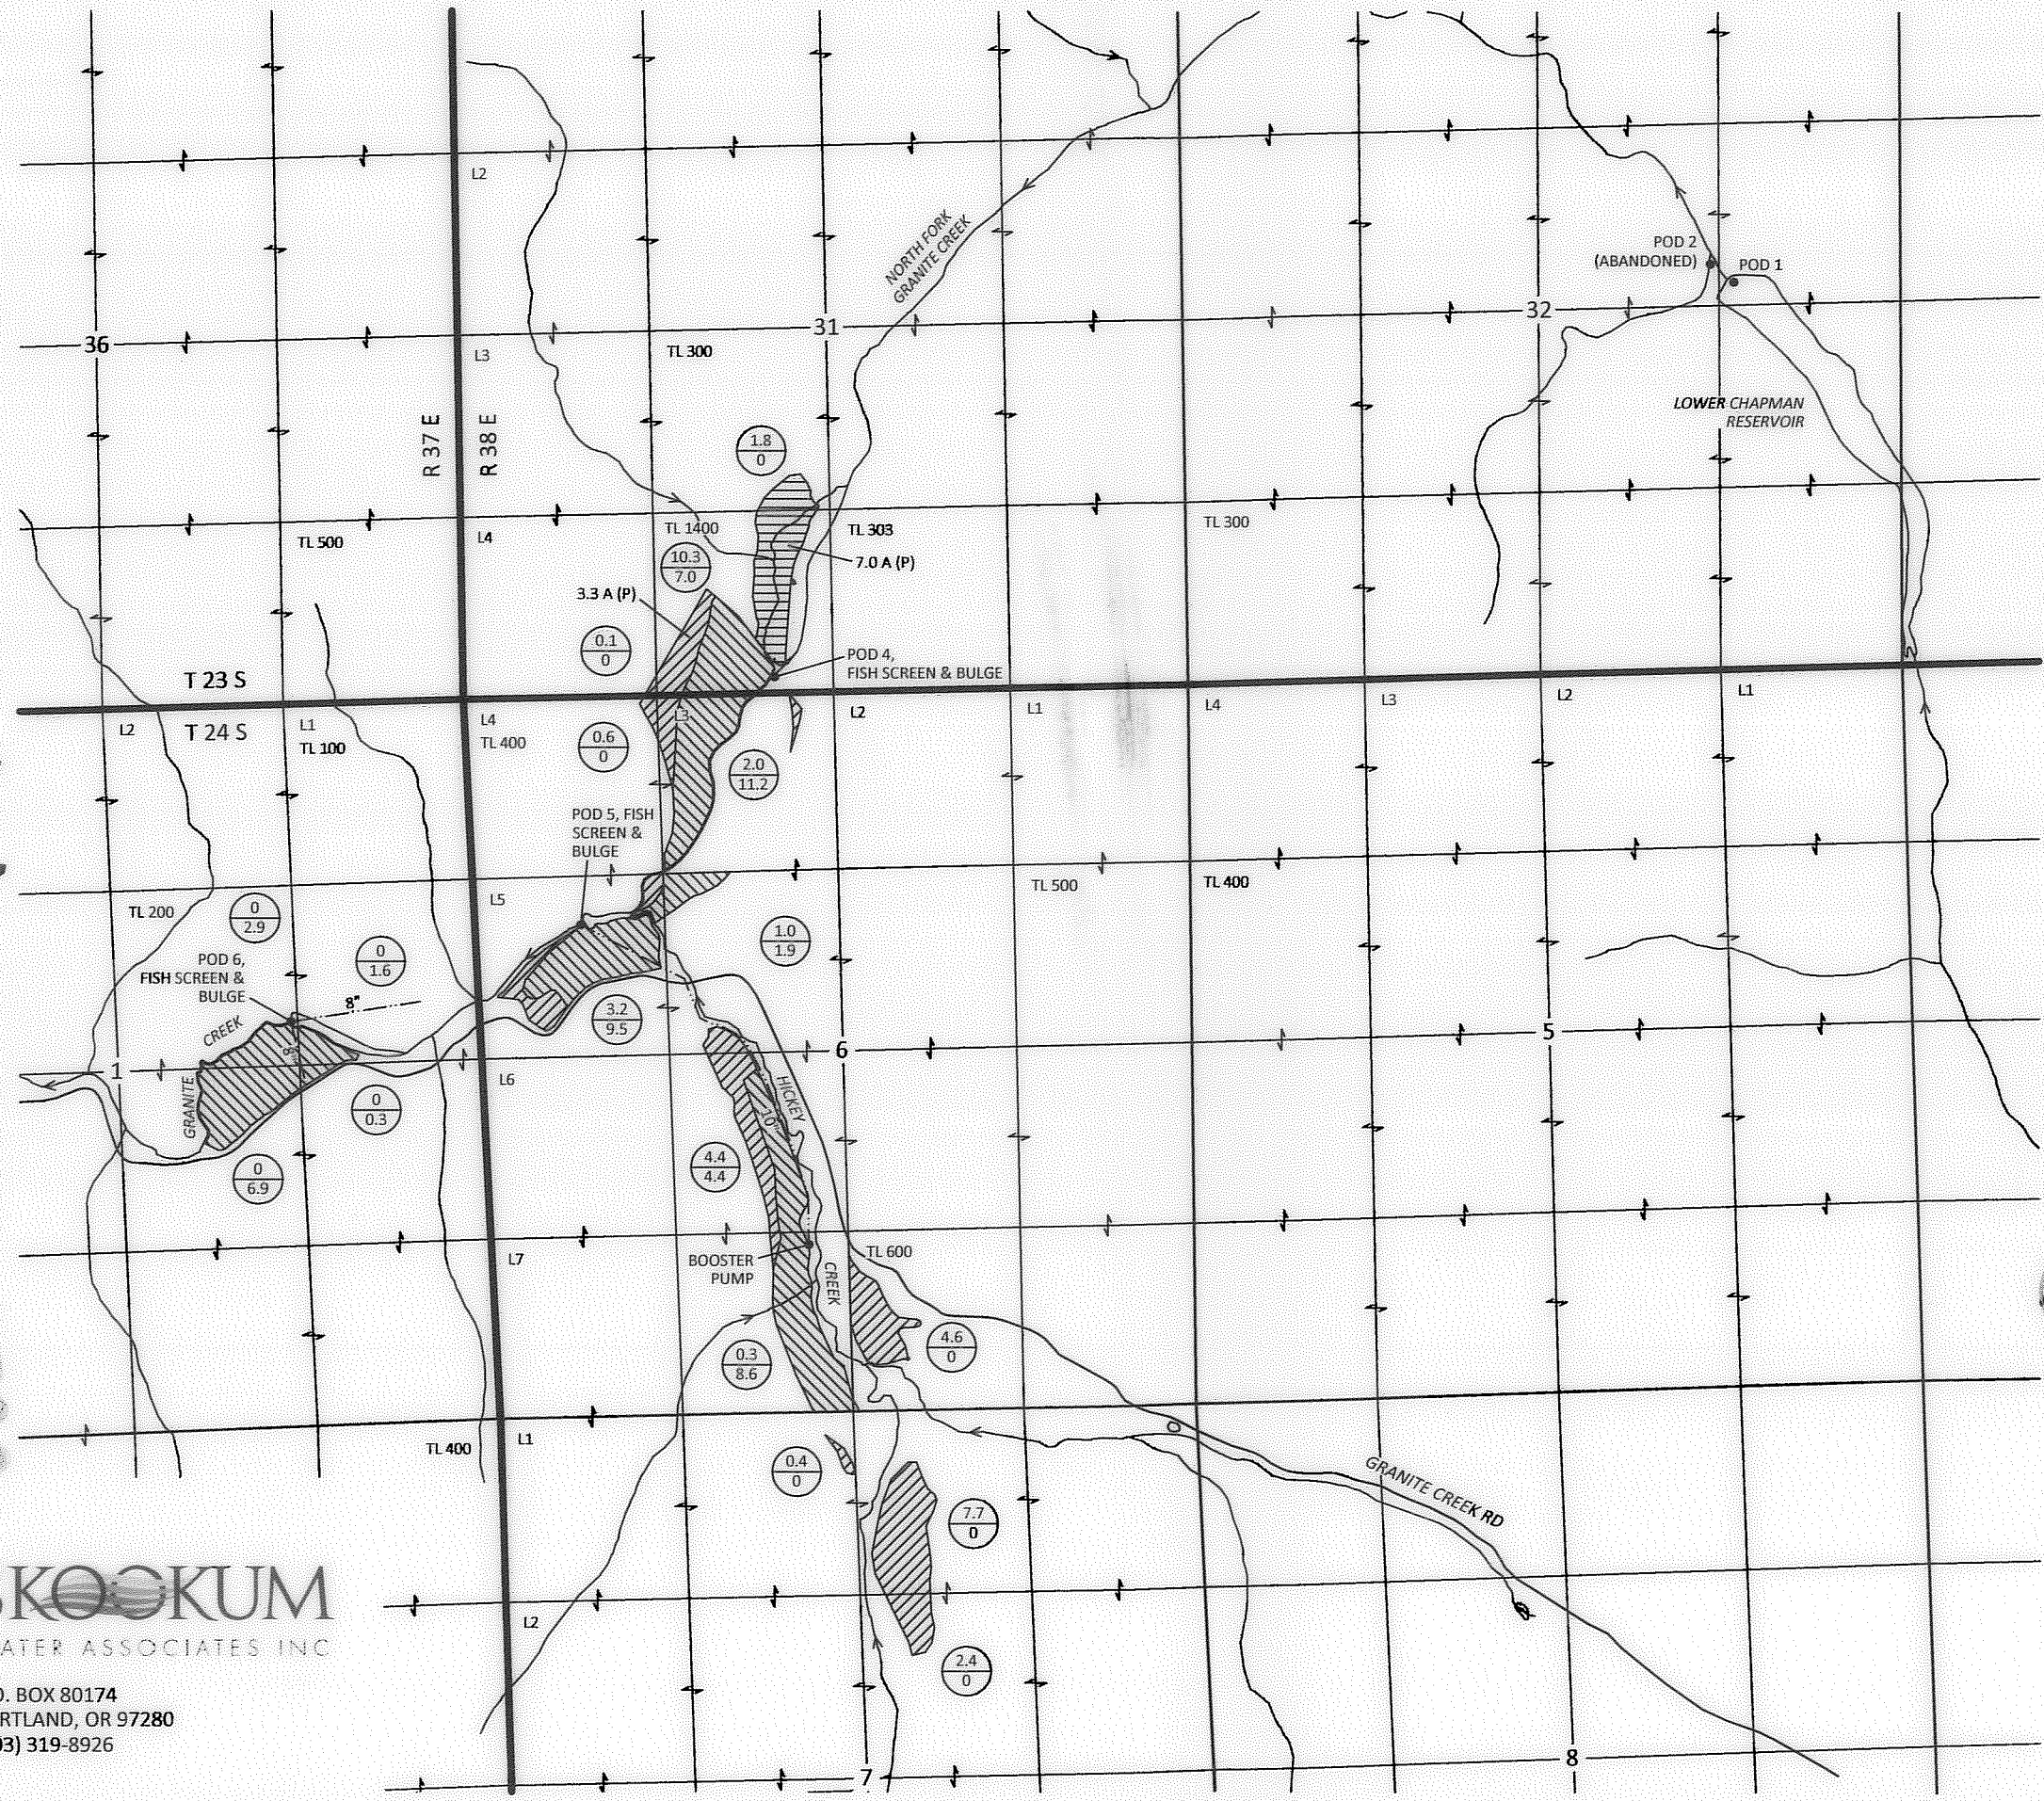

977