


T. IN., R. IW., W.M.

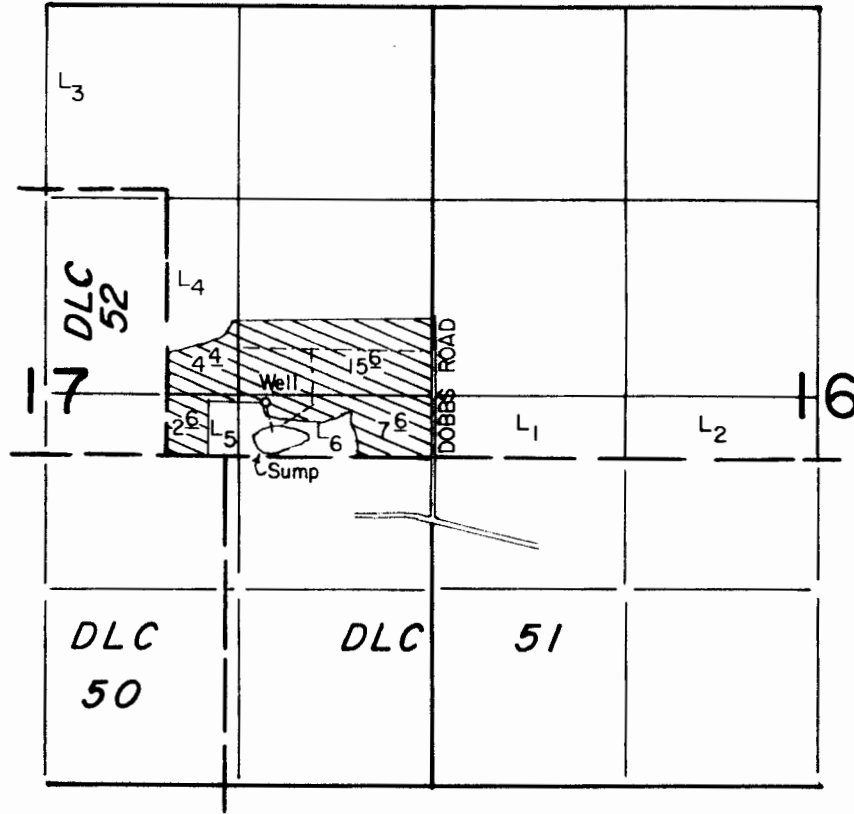

Well Loc. : 60' S. & 1130' W. from E. 1/4 Cor. Sec. 17.

Scale : 1" = 1320'

FINAL PROOF SURVEY UNDER

Application No. G-10554 Permit No. G-9807
IN NAME OF

WEST OREGON NURSERY, INC.

Surveyed AUG. 31, 1988, by T. Warren