


T. 13S., R. 28E., W. M.

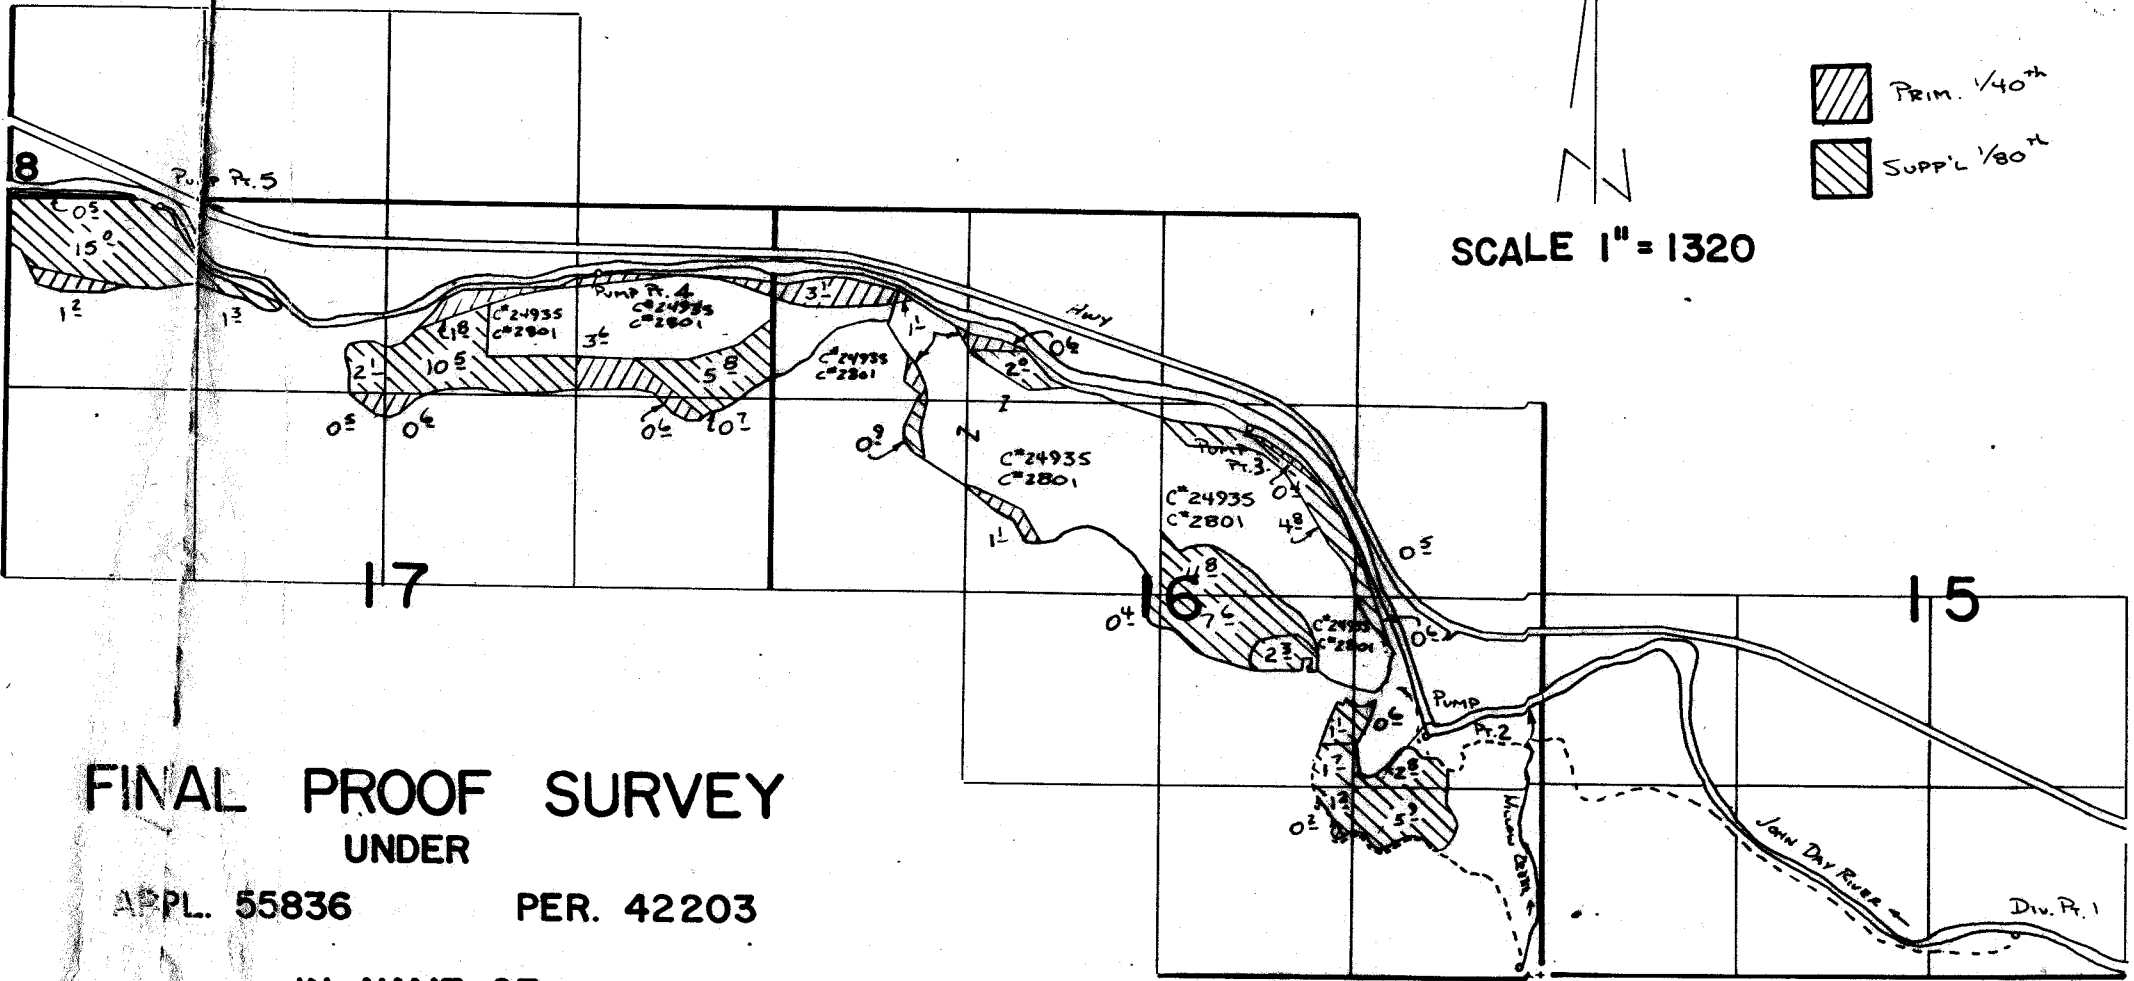

SCALE 1" = 1320

PRIM. 1/40th
SUPPL. 1/80th

FINAL PROOF SURVEY
UNDER

APPL. 55836 PER. 42203

IN NAME OF

EDWARD HINES LUMBER COMPANY

Surveyed 3-21-1986, by V.L.CHURCH

Div. Pt. 1 Loc: 300'N. & 3220' E. }
 Pump Pt. 2 Loc: 1680'N. & 810' W. } From SE' Cor. Sec. 16
 Pump Pt. 3 Loc: 3800'N. & 2050' W. }
 Pump Pt. 4 Loc: 460' S. & 4100' E. }
 Pump Pt. 5 Loc: 50' S. & 1040' E. } From NW Cor. Sec. 17