


Per # 2118  
255

3842

T. 13, S. 29, E. 11M.

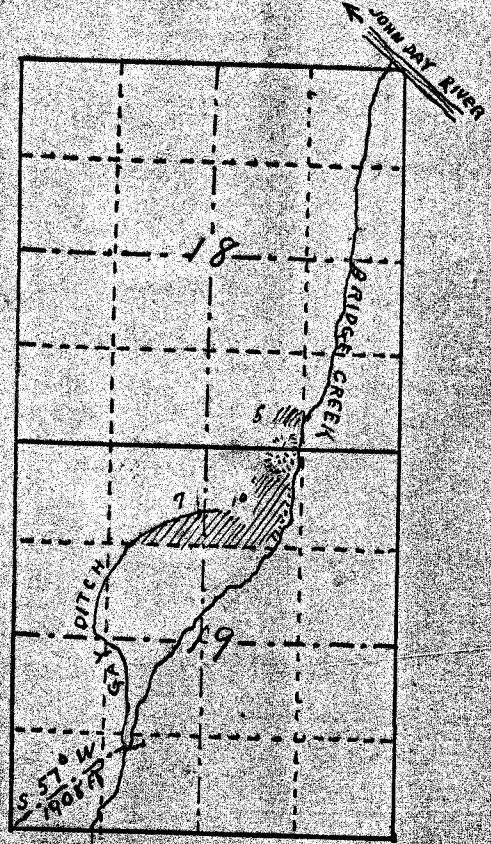

OFFICE OF STATE ENGINEER  
**RECEIVED**  
AUG 6 1914  
SALEM, OREGON

Application No. 3842  
Permit No. 2118

3842