


T 24 S, R 32 E, WM

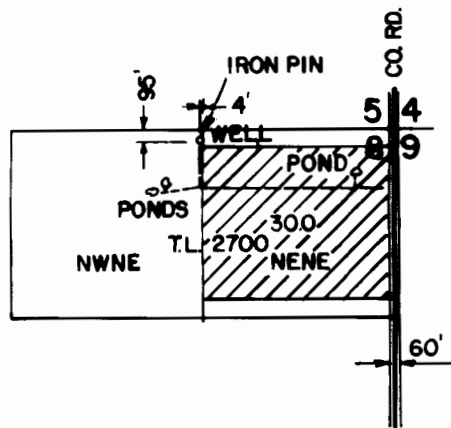

THE PURPOSE OF THIS MAP IS TO
IDENTIFY THE LOCATION OF THE
WATER RIGHT IT IS NOT INTENDED
TO PROVIDE INFORMATION RELATIVE
TO THE LOCATION OF PROPERTY
OWNERSHIP.

RECEIVED

OCT 21 2002

WATER RIGHTS SECTION

	FINAL PROOF SURVEY		
	UNDER APPLICATION G-13189 PERMIT G-11750		IN THE NAME OF JOE HENDRY
	Scale: 4" = 1 MILE	Date: OCTOBER 2002	Job: 1430-02
	Dsn: Dm: CHRIS Ckd:	M.A. PALMER & SONS, INC. ENGINEERING & SURVEYING 711 Ponderosa Village • Box 61 Burns, Oregon 97720	Sht. No. of -1