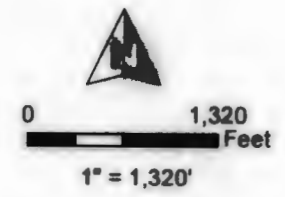
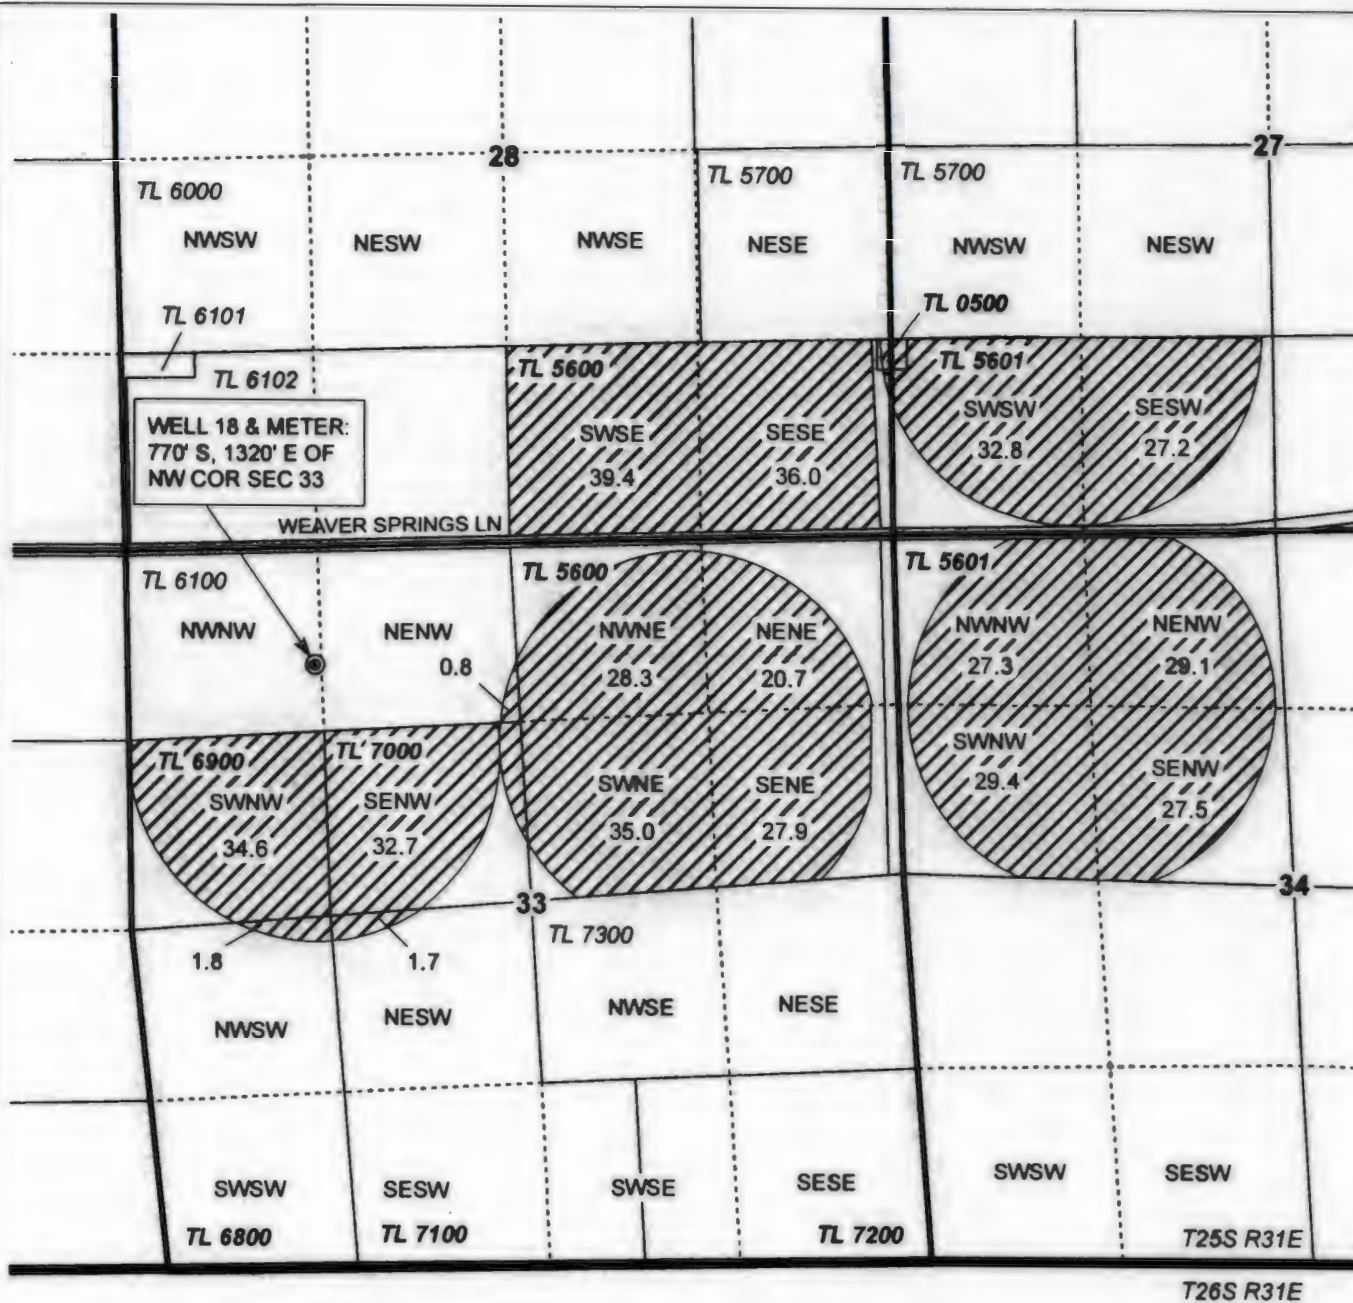

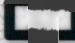

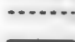




**T25S, R31E,
SECTIONS 27, 28, 33 & 34, WM**

HARNEY COUNTY, OREGON

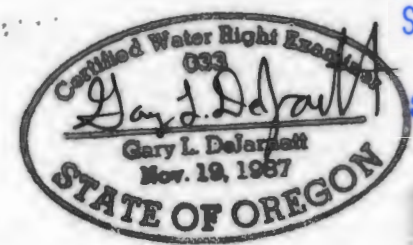


-  POU Irrigation
-  Township
-  Section
-  Quarter Quarter
-  Taxlot
-  Well

RECEIVED BY OWRC

SEP 02 2015

SALEM, OR



RENEWAL DATE 12/31/2015

CLAIM OF BENEFICIAL USE
Golden Rule Farms, Inc.

PERMIT G-14993

NOTE: THIS MAP IS NOT INTENDED TO
PROVIDE LEGAL DIMENSIONS OR LOCATIONS
OF PROPERTY OWNERSHIP LINES.

PROJECT #15041 AUGUST 11, 2015

WATER RIGHT SERVICES, LLC
PO BOX 1830, BEND, OR 97709
CCB# 197121 www.oregonwater.us
541-389-2837 JOHNSHORT@USA.COM