


# TOWNSHIP 17 SOUTH, RANGE 22 EAST, W.M.

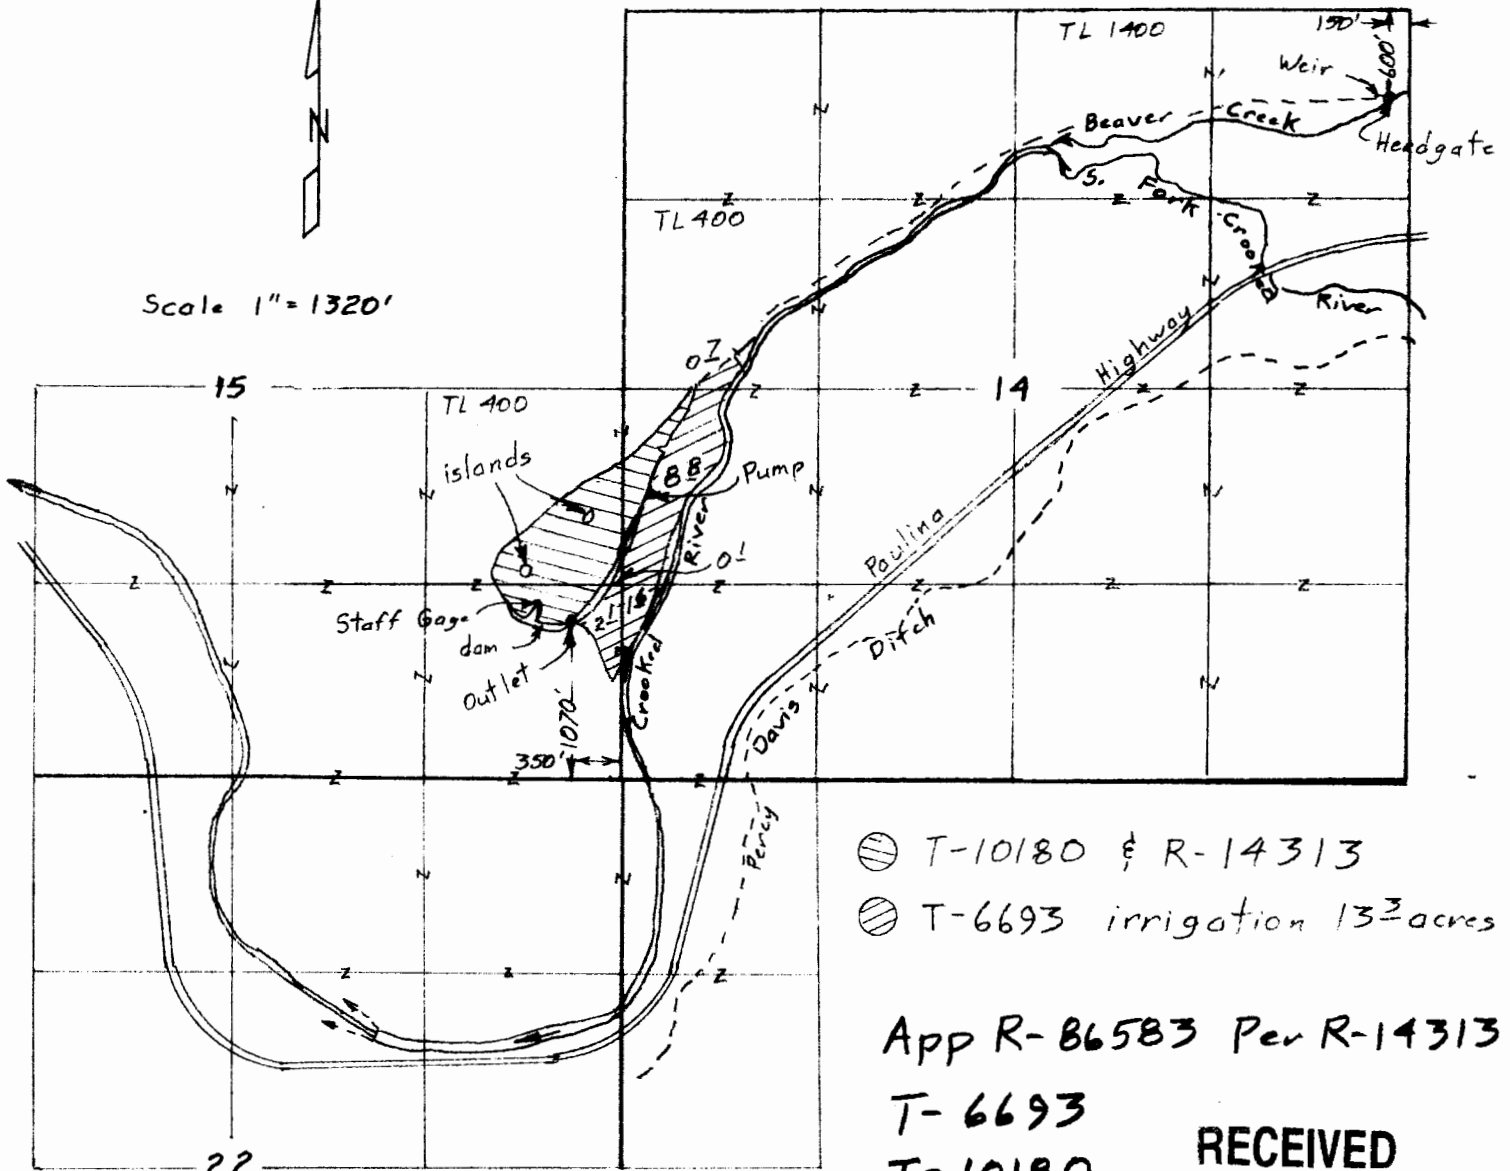

Scale 1" = 1320'



Surveyed July 1, 2009  
& March 31, 2011

- ⊗ T-10180 & R-14313
- ⊗ T-6693 irrigation 13 $\frac{3}{4}$  acres

App R-86583 Per R-14313  
T-6693  
T-10180

**RECEIVED**


AUG 30 2011

WATER RESOURCES DEPT  
SALEM OREGON

Claim of Beneficial Use Map **RECEIVED**  
for  
OREGON RANCHING CO.  
(Twin Buttes Ranch)

JUL 20 2011

WATER RESOURCES DEPT  
SALEM, OREGON

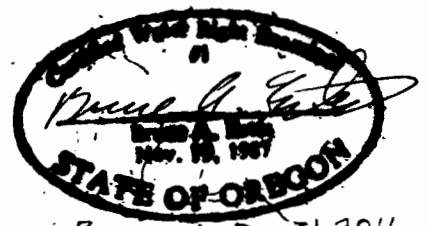

This map is for the purpose of  
locating a water right only  
and has no intent to provide  
legal dimensions or the location  
of property lines.

**ESTES SURVEYS, LLC**  
PO Box 17847  
Salem, OR 97320-7847  
(503) 328-7222  
10302 Airport Rd  
Salem, OR 97322  
(503) 328-7221