


⊙ **Point of Diversion**
 POD is pump suction located 1330 feet S and 165 feet W from NE Corner of S13. Fish screen and flowmeter at same location.

----- **Conveyance**
 Water conveyed from POD through place of use with buried mainline and applied with sprinkler systems.

 **Place of Use**
 Water beneficially used for irrigation of 4.5 acres, including 3.0 acres in the NE NE and 1.5 acres in the SE NE of Section 13, T5N, R35E, WM.


T5N, R35E, S13, WM
 Umatilla County



1 inch = 400 feet

The purpose of this map is to identify the location of a water right. It is not intended to provide information regarding the location of property ownership boundary lines.

FOUNTAINHEAD
 1204 Alvarado Terrace
 Walla Walla, WA 99362
 (509) 529-2646 phone

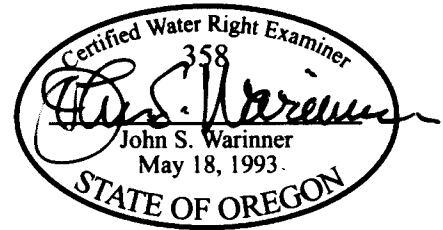

**CLAIM OF BENEFICIAL USE
 Transfer 9967**

in the name of
MATTHEW & SARAH ERLANDSON

Revised 07 OCT 2011