


T8S & T9S R3W WM

MARION COUNTY

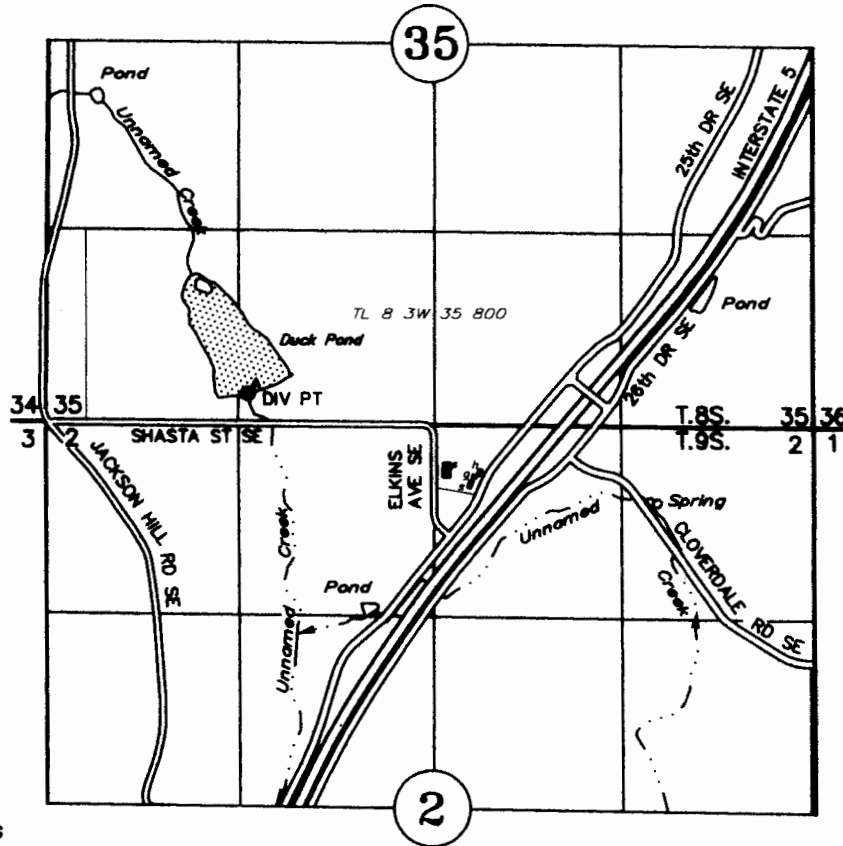

TAX LOT:
8 3W 35 800

- ▲ STAFF GAGE
- h HOUSE
- g GARAGE
- s SHED/OUTBUILDING

DIV PT: 190' NORTH AND 1385' EAST OF SW CORNER OF SECTION 35
STAFF GAGE: 240' NORTH AND 1435' EAST OF SW CORNER OF SECTION 35

Claim of Beneficial Use

Application No. R-83906 Permit No. R-12732

EGM, LLC & Douglas Fries

October 20, 2015
SCALE 1" = 1320'

NOTE: This map is for the purpose of identifying the location of water rights and has not intent to dimension or locate property ownership lines.



RENEWAL DATE: 12-31-2017