


T8S & T9S R3W WM

MARION COUNTY

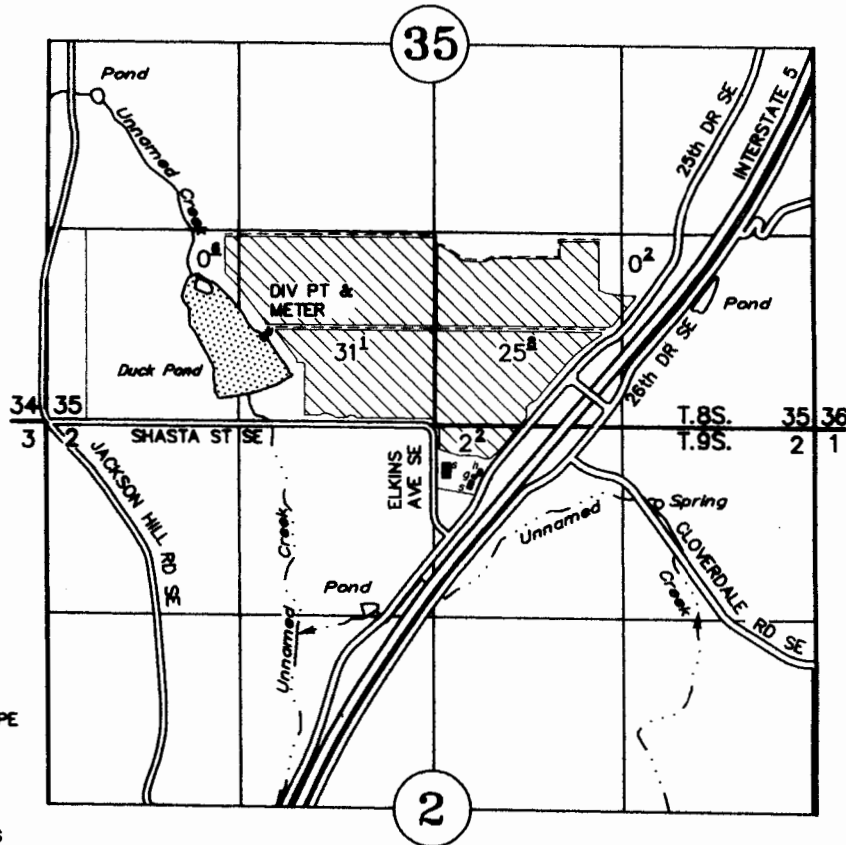

TAX LOT:
8 3W 35 800

DIV PT: 570' NORTH AND 1505' EAST OF SW CORNER OF SECTION 35
METER: 585' NORTH AND 1520' EAST OF SW CORNER OF SECTION 35

Claim of Beneficial Use

Application No. S-83907 Permit No. S-53601

EGM, LLC & Douglas Fries

October 20, 2015
SCALE 1" = 1320'



NOTE: This map is for the purpose of identifying the location of water rights and has not intent to dimension or locate property ownership lines.

RENEWAL DATE: 12-31-2017