


T8S & T9S R3W WM

MARION COUNTY

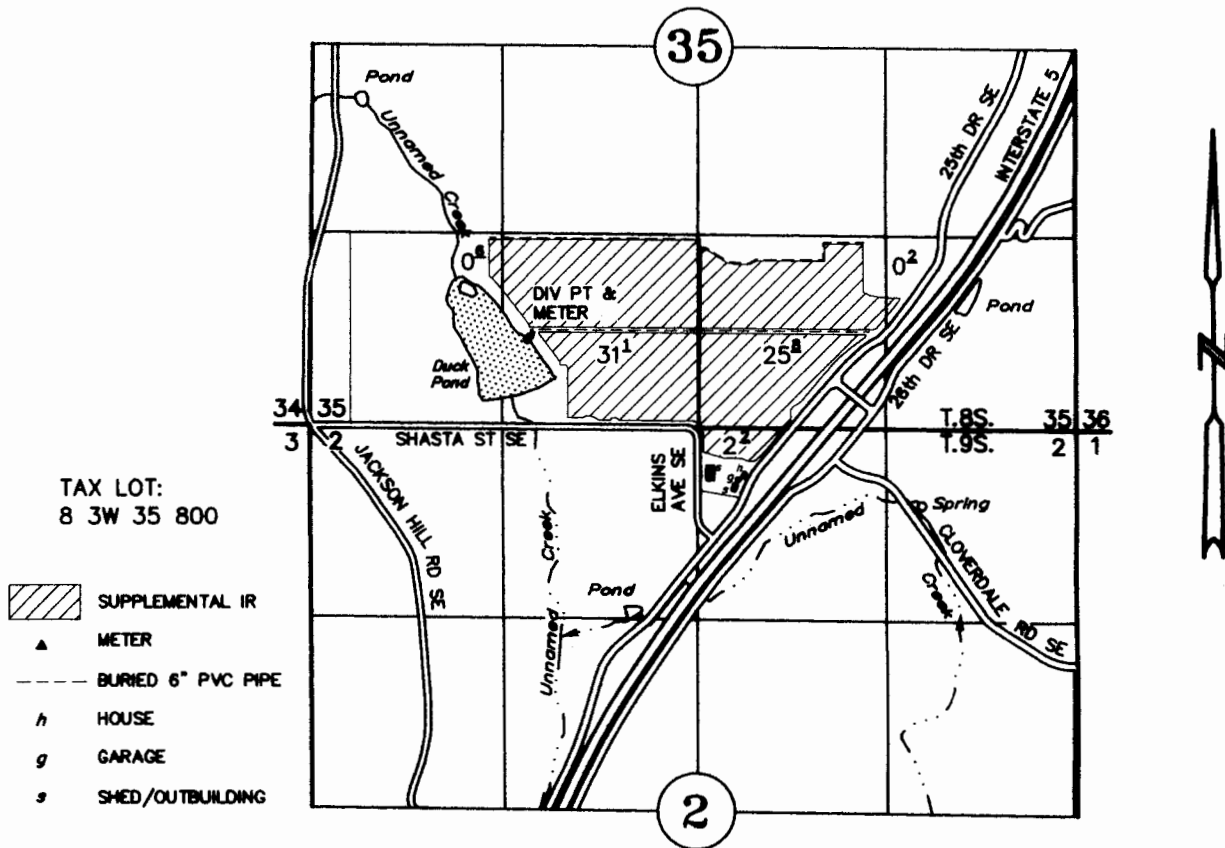

DIV PT: 570' NORTH AND 1505' EAST OF SW CORNER OF SECTION 35
METER: 585' NORTH AND 1520' EAST OF SW CORNER OF SECTION 35


Claim of Beneficial Use

Application No. S-85817 Permit No. S-54099

EGM, LLC

October 20, 2015
SCALE 1" = 1320'

NOTE: This map is for the purpose of identifying the location of water rights and has not intent to dimension or locate property ownership lines.

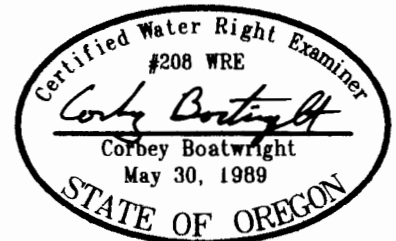

RENEWAL DATE: 12-31-2017