


The final proof survey and inspection of the water use as found to be completed under the terms and conditions of Permit #S-53800 was completed by me on March 22, 2004, and the facts contained in this report and map are correct to the best of my knowledge.

Bob Pankratz, PE, CWRE
Water Right Examiner

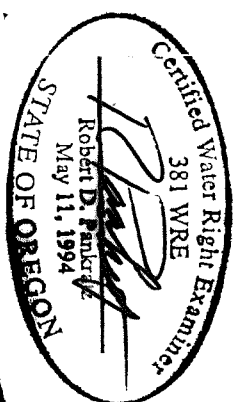

NOTE:
Map is for purpose of identifying location of Water Right and has not intent to dimension or locate property ownership lines.

CLAIM OF BENEFICIAL USE

TO CONSTRUCT A RESERVOIR and STORE PUBLIC WATERS

RECEIVED

APR 09 2004

WATER RESOURCES DEPT
SALEM, OREGON

Section 17, Twp 7S, Range 4W
Tax Lot # 100 (7-4-17 & 20)
Polk County, Oregon

FOR: Mark Knaupp

Application # R-84301 Permit # R-12878

Date Surveyed: Feb. 6, 2004

OWNER INFORMATION:

Permittee:
Mark Knaupp
1875 Greenwood Road N
Rickreall, Oregon 97371

Property Owner: Person interviewed:
(same as above)

SOURCE OF WATER: Mud Slough, a tributary of Rickreall Crk

STORAGE FACILITY: Mud Slough Reservoir 1


PURPOSE OF USE OF STORED WATER: Wetland Enhancement

DATE OF PRIORITY: November 24, 1999

WATER MAY BE APPROPRIATED FOR STORAGE DURING THE PERIOD: November 1 through June 30 of each year

USGS Map - RICKREALL QUAD (Rev. 1976)

NOTE: The reservoir may be emptied to Mud Slough by gravity flow and valving (GV).

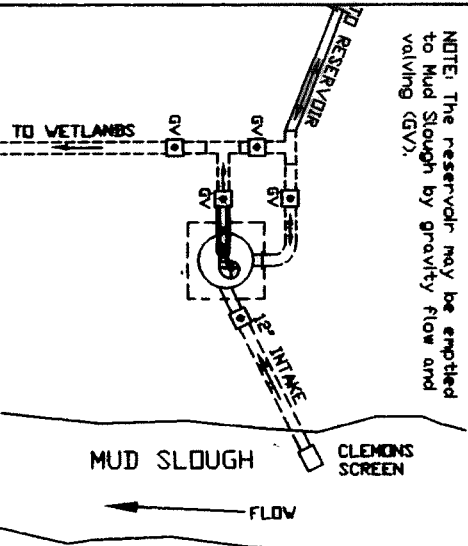

Reservoir #1 Volume is 3,105,990 CF = 71.3 A-F

ELEV. AREA (SF)	DEPTH(FT)	VOL.(CF)	ΣVOL.(CF)
95.0	327	30,150	30,150
96.0	59,990	82,335	112,473
97.0	104,720	121,040	233,514
98.0	137,360	179,615	413,129
99.0	221,070	99	2,692,790
100.0	382,180		3,105,990

See 'Alternate Review' Application for additional 8.3 A-F

PUMP SYSTEM PLAN VIEW

DIVERSION PT.

(See Sht 1/4)

10' I.E.=97.0
STORAGE GAUGE

AREA @ EL.96.0 = 59,990 SF
10' I.E.=97.0
STORAGE GAUGE

16" Transmission piping (to wetlands)

