


Sec. 18

Tp. 117

R. 10 E.

8898

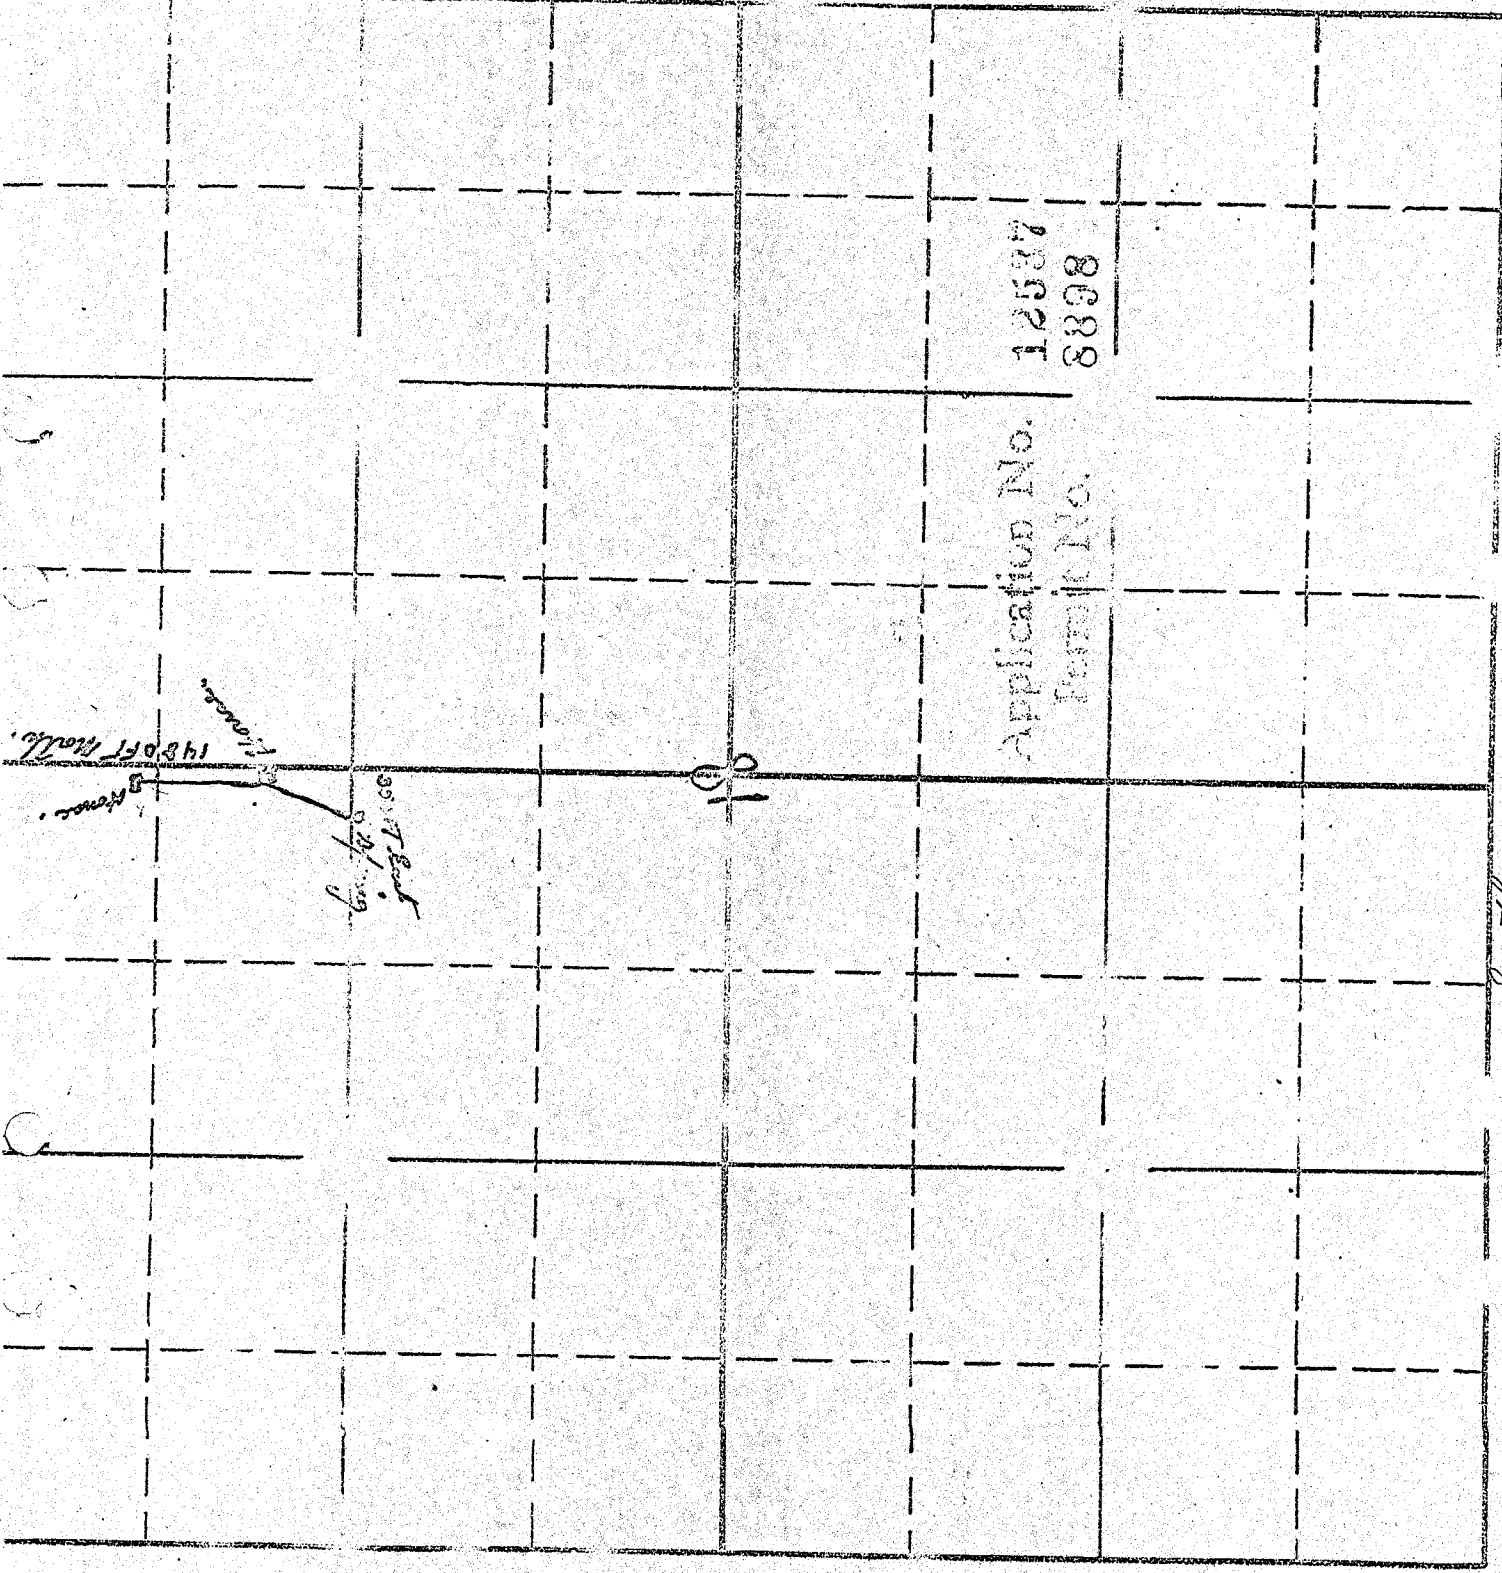

Application No. 12537
 Permit No. 8898

South