


T.8S. R.2W. Sec. 11, & 12, W.M.

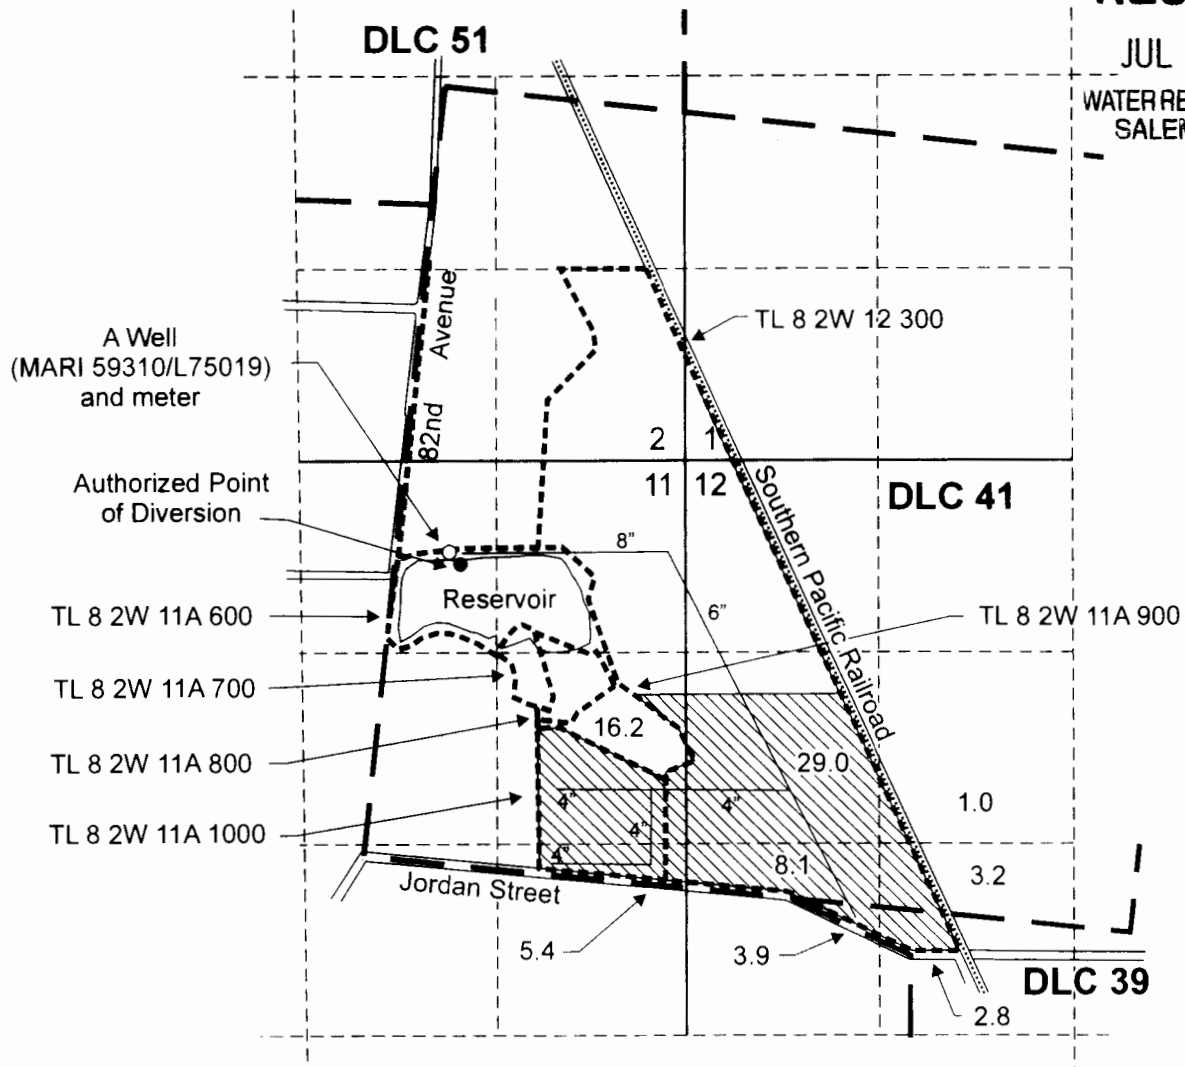


RECEIVED

JUL 07 2011

WATER RESOURCES DEPT
SALEM, OREGON

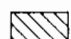


Authorized point of diversion (primary irrigation) is located 690 feet S. and 1,070 feet E. from the N 1/4 corner of Section 11.
Authorized point of appropriation (MARI 59310/L75019, supplemental irrigation) is located 650 feet S. and 1,040 feet E. from the N 1/4 corner of Section 11.

-  Area (69.6 Acres) to be irrigated (primary and supplemental)
-  Tax lot Boundary
-  Mainline



EXPIRATION DATE 6/30/13

Scale: 1" = 1,320'

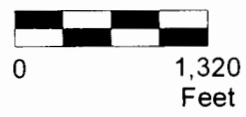

This map was prepared for the purpose of identifying the location of a water right only and is not intended to provide legal dimensions or location of property ownership lines.

**Claim of Beneficial Use Map
Transfer 9821**

Pacific Hydro-Geology Inc.

T.8S. R.2W. Sec. 1, 2, 11, and 12

4/2011 - bg-p

Heritage Seedlings, Ltd.