


RECEIVED BY OWRD

MAY 13 2015

SALEM, OR

NW 1/4 OF THE SW 1/4
NE 1/4 OF THE SW 1/4
SECTION 30
T2S, R6E of the WM
CLACKAMAS COUNTY, OREGON

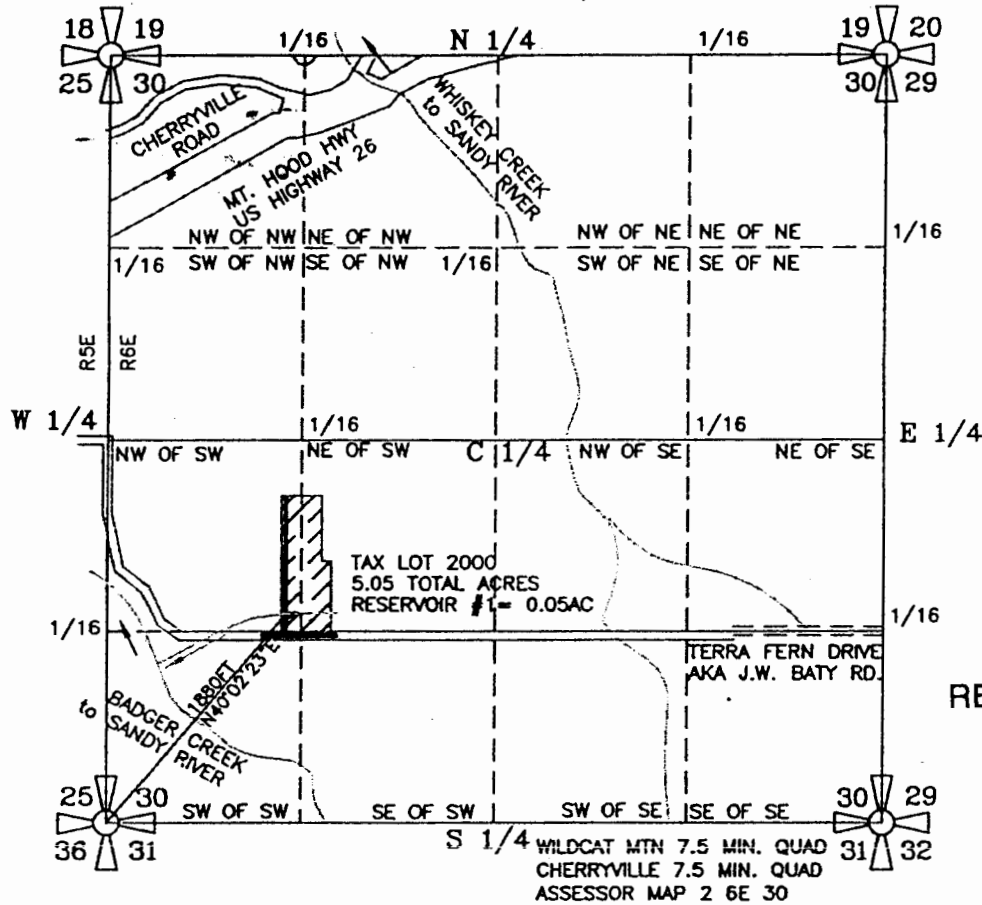

RECEIVED BY OWRD


MAY 28 2015

SALEM, OR

SEC. 1/4 1/4	RESERVOIR AC	VOLUME: AC-FT
30	SW SW	0.05 AC
	SW SW	NO IRRIGATION
	SW SW	RECREATION
RESERVOIR	0.05 ACRES	0.15 AC-FT


Application No. P84954
Permit No.

RES #1 IS LOCATED 1440 FEET NORTH AND 1210 FEET EAST OF THE SOUTHWEST CORNER OF SECTION 30, TOWNSHIP 2 SOUTH & RANGE 6 EAST OF THE WM, CLACKAMAS COUNTY, STATE OF OREGON

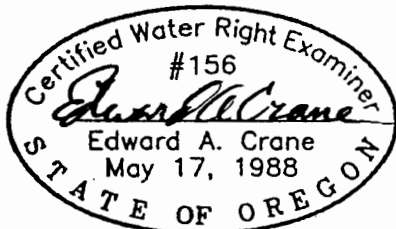

Renewal 12/31/97
Signed _____

SURVEYED OCT. 10, 2001
BY EDWARD A. CRANE, CWRE

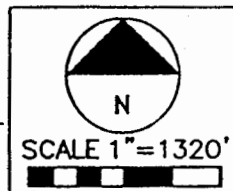

PREPARATION OF THIS MAP WAS FOR THE PURPOSE OF IDENTIFYING THE LOCATION OF THE WATER RIGHTS ONLY AND HAS NO INTENT TO PROVIDE DIMENSIONS OR LOCATION OF PROPERTY OWNERSHIP LINES.

APPLICATION FOR A PERMIT
TO STORE WATER R- _____

PREPARED BY EDWARD A. CRANE, CWRE

DATE
OCT. 2001
PROJECT NO.
402-001



CRANE & MERSETH
Engineering/Surveying
SUITE "D"
6566 SE LAKE ROAD
MILWAUKIE, OREGON 97222
BUS: (503) 654-2005
FAX: (503) 654-2575

APPLICATION FOR PERMIT NUMBER R- _____
PERMIT NUMBER R- _____ IN THE NAME OF:

PAUL and CARRI BENDER
52727 E. TERRA FERN DRIVE
SANDY, OR 97055 (TEL: 503-668-0388)

SHEET

1/2

W 1/4

TERRA FERN DRIVE

RECEIVED BY OWRD

MAY 13 2015

SALEM, OR

TAX LOT 2000
5.05 TOTAL ACRES
RESERVOIR #1 = 0.05AC

NW OF SW

NE OF SW

NW 1/4 OF THE SW 1/4
NE 1/4 OF THE SW 1/4
SECTION 30
T2S, R6E of the WM
CLACKAMAS COUNTY, OREGON

C 1/4

TRIBUTARY OF DADGER CREEK
NORMALLY DRY IN SUMMER

1/16

1/16

TERRA FERN DRIVE

TOP ROAD
6'-4" OVER
BOTTOM CRK
OLD 18"
CULV.
WAS
REMOVEDEXISTING
DRIVEWAY
RAISED 40"
OVER OLD GRADEEXISTING
DRIVEWAY1880 FT
N40°02'23"ENEW 3-10" SCALE: 1" = 100'
CULV.
INSTALLED
AS OVERFLOW

RECEIVED BY OWRD

MAY 28 2015

SALEM, OR

Permit No.


WILDCAT MTN 7.5 MIN. QUAD
CHERRYVILLE 7.5 MIN. QUAD
ASSESSOR MAP 2 6E 30

SW OF SW


SE OF SW

1/16

S 1/4

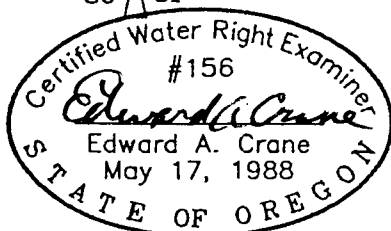Renewal 12/31/97
Signed _____SURVEYED OCT. 10, 2001
BY EDWARD A. CRANE, CWRE

K:\CAD\402-001\40200101.DWG 10/11/2001 EAC

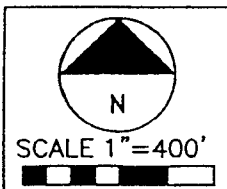RES #1 IS LOCATED 1440 FEET NORTH AND 1210 FEET EAST OF
THE SOUTHWEST CORNER OF SECTION 30, TOWNSHIP 2 SOUTH &
RANGE 6 EAST OF THE WM, CLACKAMAS COUNTY, STATE OF OREGONPREPARATION OF THIS MAP WAS FOR THE PURPOSE
OF IDENTIFYING THE LOCATION OF THE WATER RIGHTS
ONLY AND HAS NO INTENT TO PROVIDE DIMENSIONS
OR LOCATION OF PROPERTY OWNERSHIP LINES.APPLICATION FOR A PERMIT
TO STORE WATER R- _____

PREPARED BY EDWARD A. CRANE, CWRE

DATE
OCT. 2001
PROJECT NO.
402-001CRANE & MERSETH
Engineering/Surveying
SUITE "D"
6566 SE LAKE ROAD
MILWAUKIE, OREGON 97222
BUS: (503) 654-2005
FAX: (503) 654-2575APPLICATION FOR PERMIT NUMBER R- _____
PERMIT NUMBER R- _____ IN THE NAME OF:PAUL and CARRI BENDER
52727 E. TERRA FERN DRIVE
SANDY, OR 97055 (TEL: 503-668-0388)SHEET
2/2