



T.2N. R.3W. Section 31

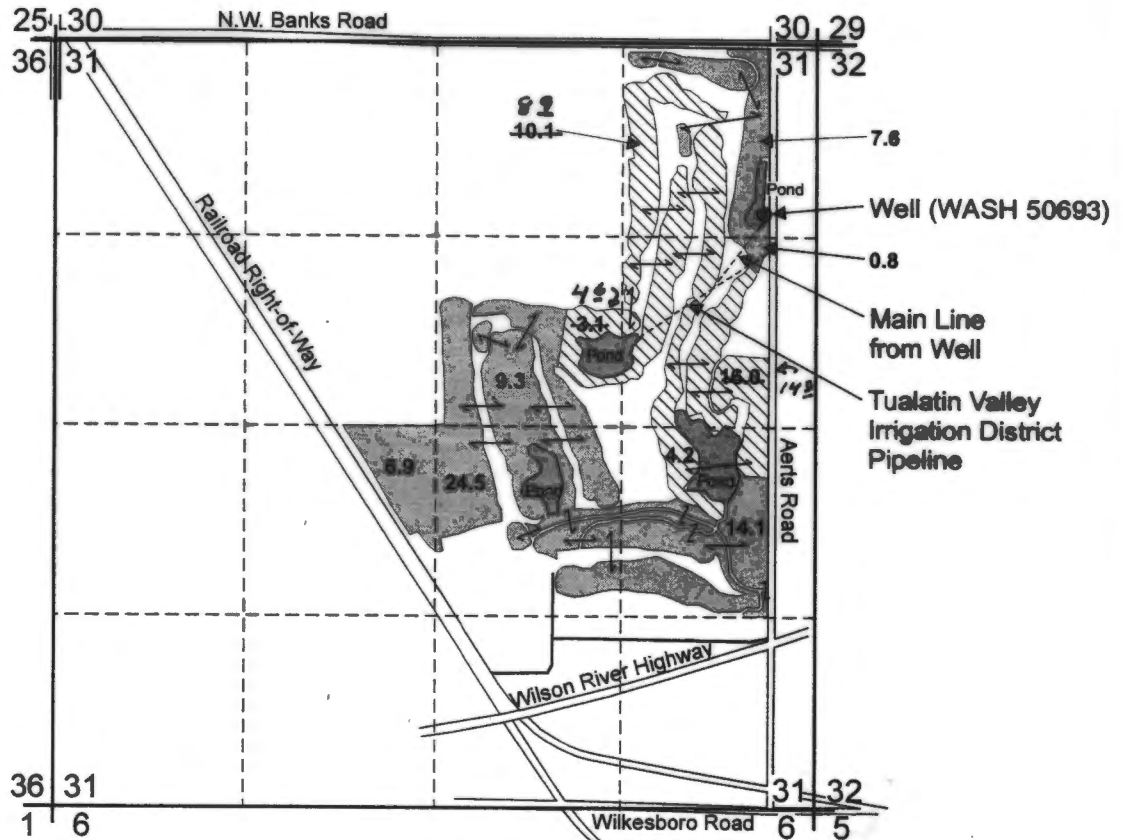

Well (WASH 50693) is located 1,170 feet south and 2,250 feet east of the north 1/4 corner of Section 31.

 Area (33.4 acres) to be supplemental to acreage irrigated under contract with the Tualatin Valley Irrigation District (TVID); *Certificate 88122*

 Area (63.2 acres) to be supplemental to acreage irrigated by excess, non-contracted water normally made available by the TVID, or to become primary in the event that water is not delivered by TVID.

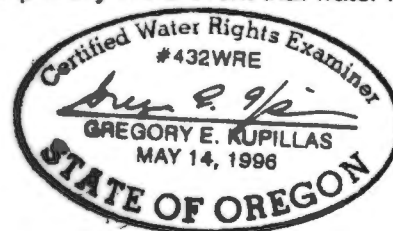

EXPIRATION DATE: 6/30/02

Scale: 1" = 1,320'



This map was prepared for the purpose of identifying the location of a water right only and is not intended to provide legal dimensions or location of property ownership lines

Claim of Beneficial Use Map

Quail Valley Golf Corporation
T.2N. R.3W. Section 31

Pacific Hydro-Geology Inc.

5-12-16

Map revised by WRD to reflect area in regards to underlying right. *mfb/wro*