

**FINAL PROOF SURVEY MAP
IN THE NAME OF DOUGLAS COUNTY**


FILE 23 W

APPLICATION 69481

PERMIT 50868

WATER RIGHTS DIVISION
STATE OF OREGON

TOWNSHIP 31 SOUTH, RANGE 4 WEST, W.M.

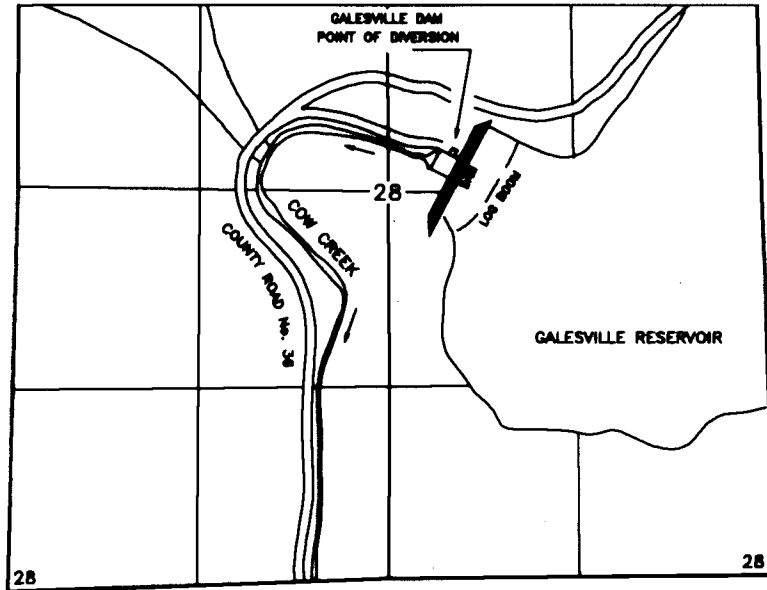


GALESVILLE DAM:

THE POINT OF DIVERSION IS LOCATED 2,865 FEET NORTH AND 2,190 FEET WEST FROM THE SOUTHEAST CORNER OF SECTION 28, BEING WITHIN THE SPANNE OF SECTION 28, TOWNSHIP 31 SOUTH, RANGE 4 WEST, W.M., DOUGLAS COUNTY.

**TOWNSHIP 32 SOUTH, RANGE 6 WEST, W.M.
CONTRACT No. U&I-87-03**

COW CREEK:

THE POINTS OF DIVERSION ARE LOCATED AS FOLLOWS: NUMBER ONE IS 196 FEET NORTH AND 1,980 FEET EAST WITHIN THE SPANNE AND NUMBER TWO IS 160 FEET NORTH AND 1,090 FEET EAST WITHIN THE SPANNE; BOTH FROM THE SOUTHWEST CORNER OF SECTION 33, TOWNSHIP 32 SOUTH, RANGE 6 WEST, W.M., DOUGLAS COUNTY.

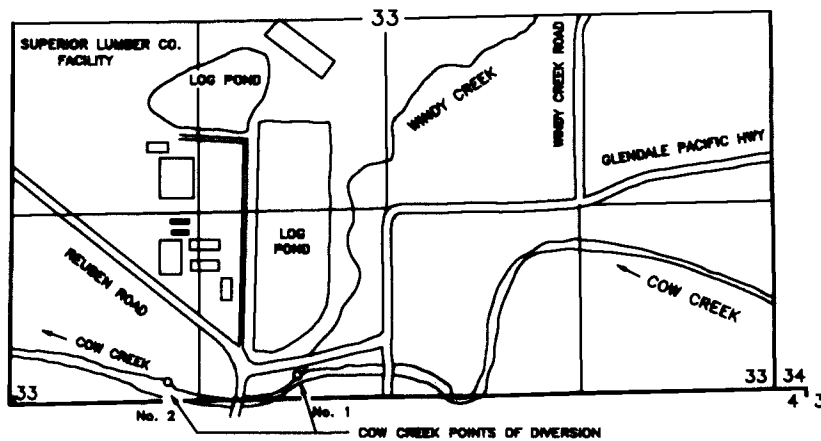

THE PURPOSE OF THIS MAP IS TO IDENTIFY THE LOCATION OF THE WATER RIGHT. IT IS NOT INTENDED TO PROVIDE INFORMATION RELATIVE TO THE LOCATION OF PROPERTY OWNERSHIP BOUNDARY LINES.

