

**LEGEND**


- SECTION LINE
- 1/4 1/4 LINE
- TAX LOT LINE
- DITCH LINE
- SECTION CORNER
- SECTION CENTER
- TAX LOT NUMBER
- POA 1 (WELL)
- IRRIGATED UNDER PERMIT G-16037
- IRRIGATED ACRES
- 1/4 1/4 SECTION

**WELL TIE**

POA 1 WELL: ±100' SOUTH & ±160' EAST FROM THE NW CORNER OF THE NE QUARTER OF SECTION 19.

**NOTES**

1. THIS MAP WAS PREPARED FROM FIELD MEASUREMENTS AND KLAMATH COUNTY TAX MAPS T33S, R07.5E, SEC. 19 & 20.
2. THIS MAP IS FOR THE PURPOSE OF IDENTIFYING THE LOCATION OF THE WATER RIGHT ONLY AND HAS NO INTENT TO PROVIDE LEGAL DIMENSIONS OR LOCATIONS OF PROPERTY OWNERSHIP LINES.
3. FOR TAX LOT INFORMATION, SEE TAX MAPS INCLUDED WITH THIS COBU.
4. DATE OF PRIORITY FOR THIS APPLICATION IS JANUARY 11, 2005.

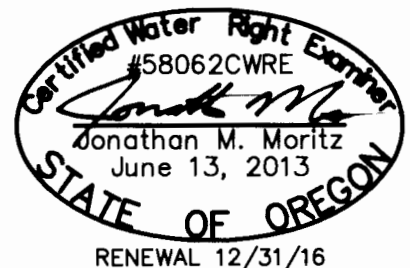

**TAX LOT NUMBERS**

- R-3307-V0000-03800-000
- R-3307-V0000-04000-000
- R-3307-V0000-04300-000

RECEIVED BY DWRD

**ADKINS**  
 CONSULTING ENGINEERING, LLP  
 2950 Shasta Way · Klamath Falls, Oregon 97603 · (541) 884-4666 · FAX (541) 884-5335  
 Oregon · California

SALEM, OR  
 Engineers ▲ Planners ▲ Surveyors

DEC 07 2015

10-13-15 1266-06

**CLAIM OF BENEFICIAL USE AND FINAL PROOF MAP**  
 FOR  
 UPPER KLAMATH FARMS  
 T.33S., R.7.5E., SEC. 19 & 20, W.M.  
 KLAMATH COUNTY, OREGON  
 PERMIT No. G-16037  
 APPLICATION No. G-16366