


996

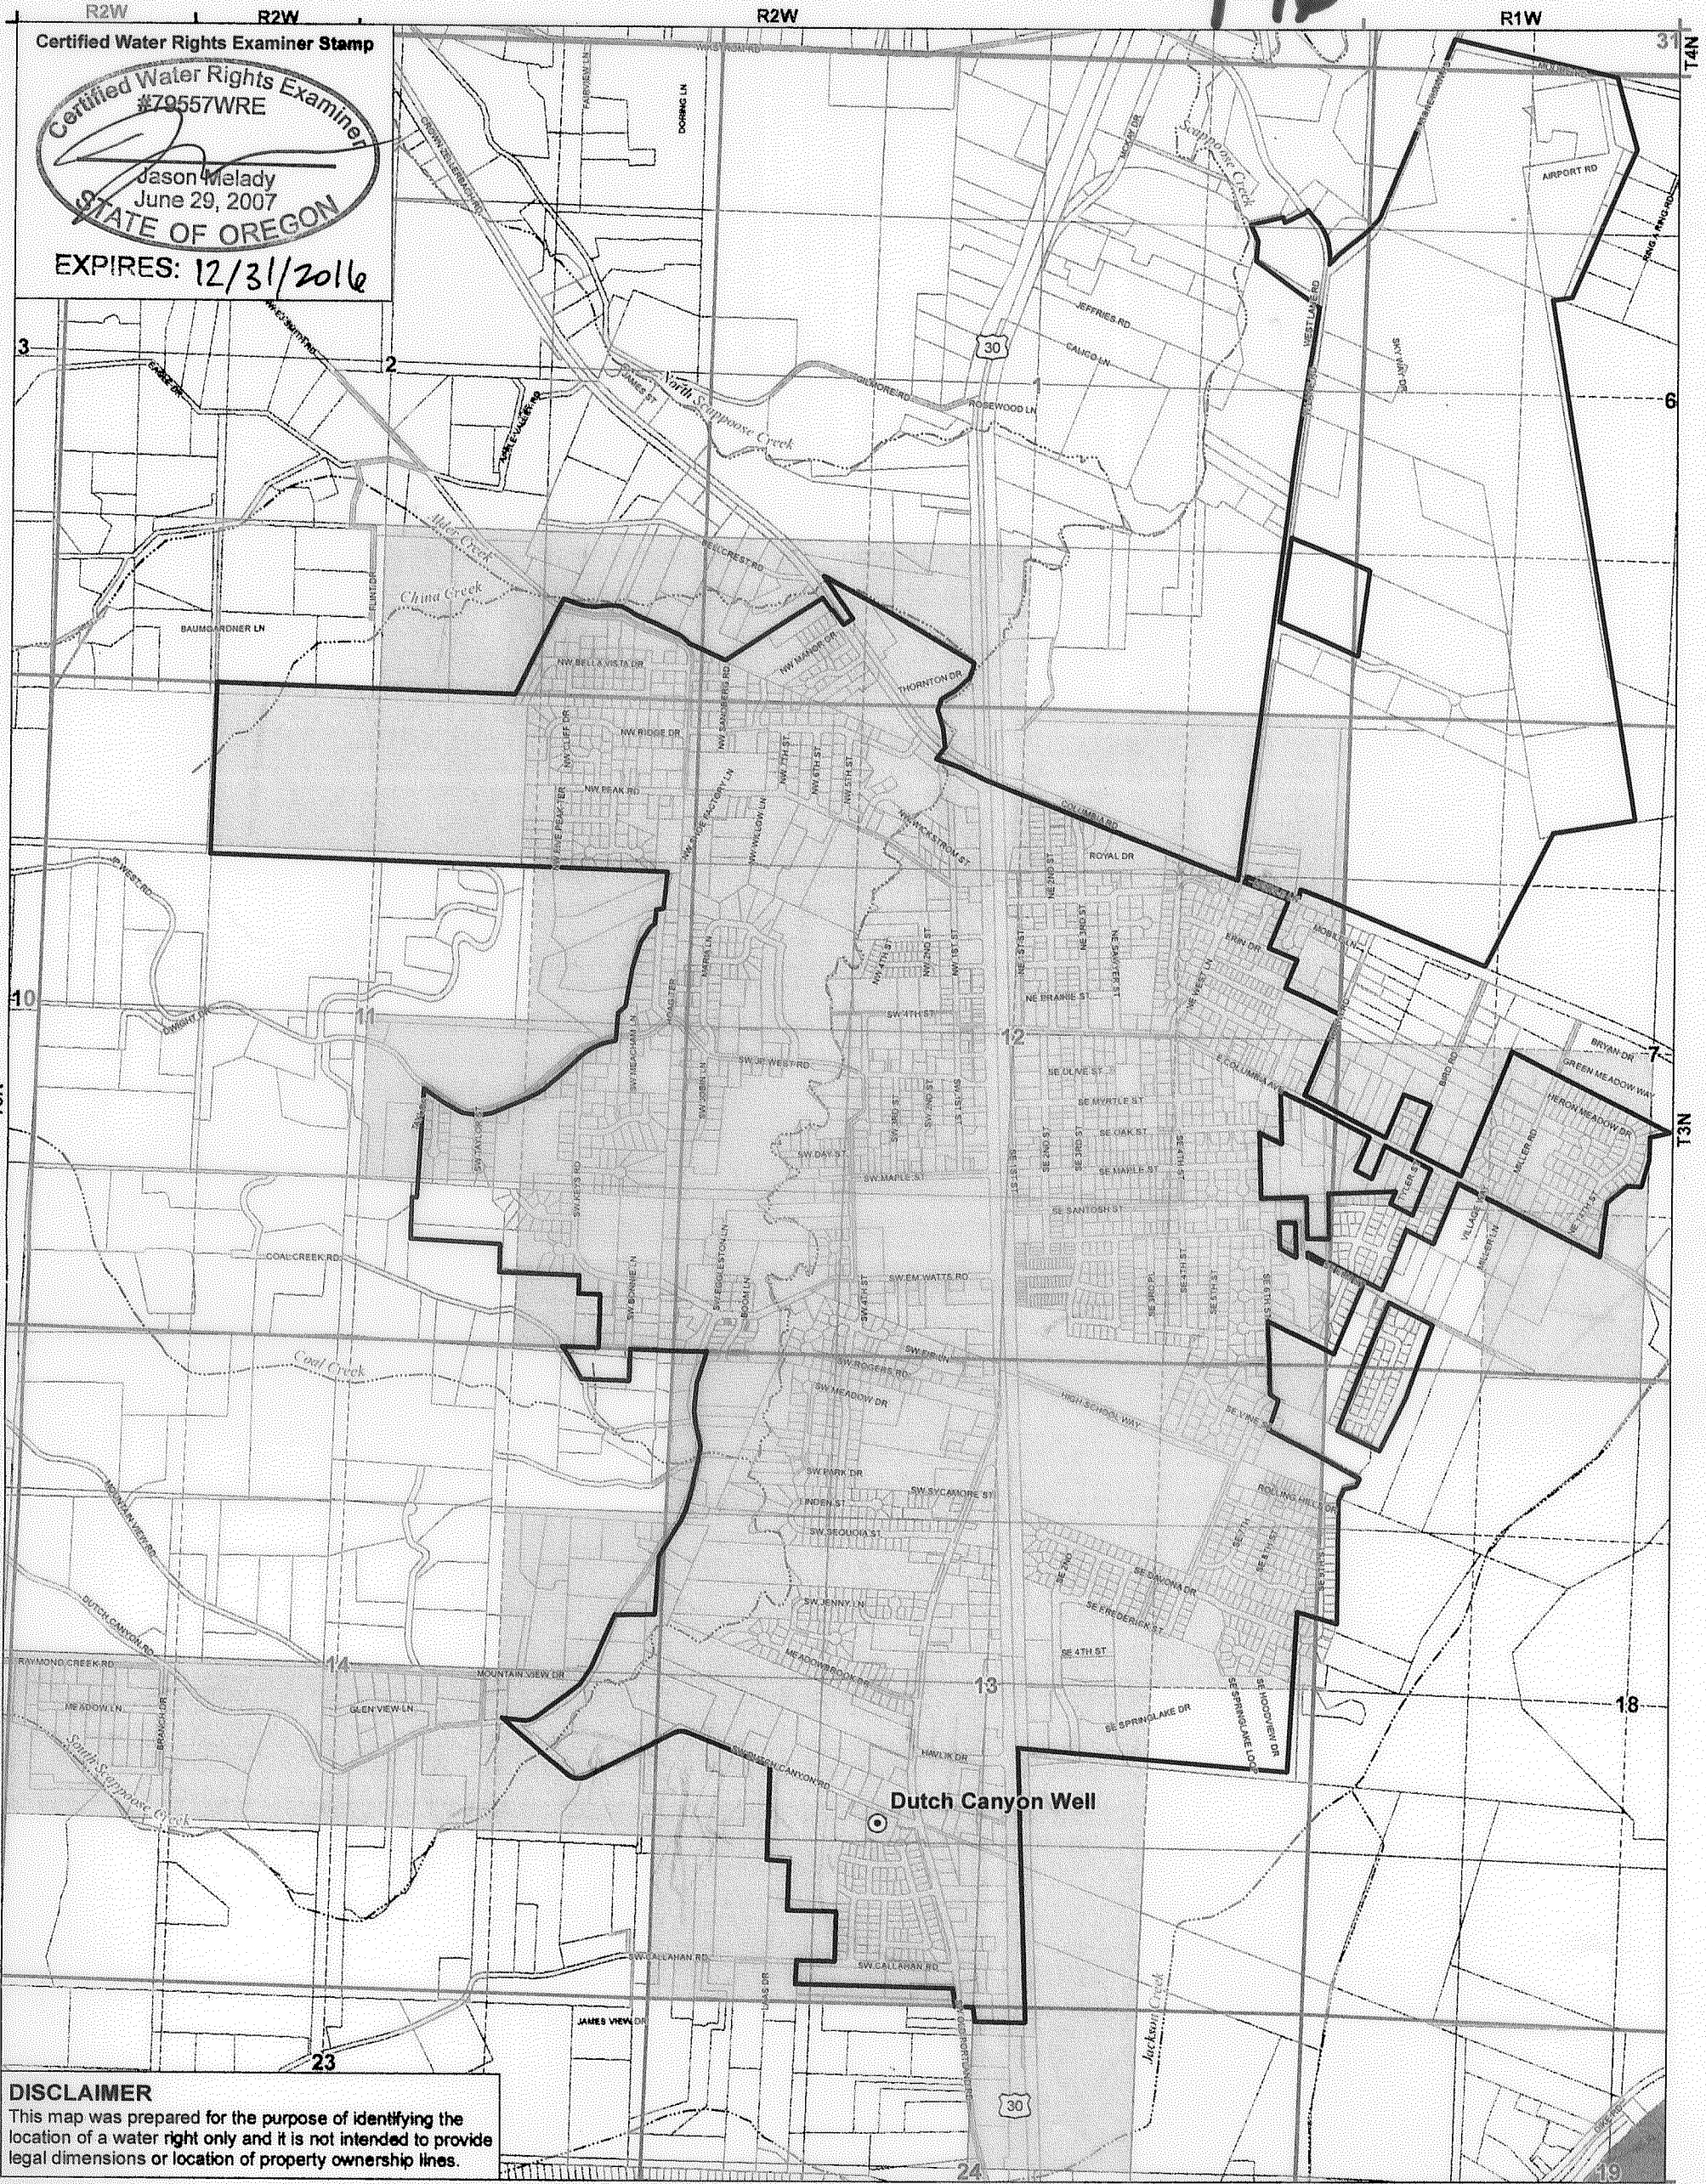

Certified Water Rights Examiner Stamp

Certified Water Rights Examiner
 #79557WRE
 Jason Melady
 June 29, 2007
 STATE OF OREGON
 EXPIRES: 12/31/2016

DISCLAIMER
 This map was prepared for the purpose of identifying the location of a water right only and it is not intended to provide legal dimensions or location of property ownership lines.

- LEGEND**
- ⊙ Point of Appropriation (POA)
 - Place of Use (POU)
 - ▭ Scappoose City Limits
 - ⊕ Tax Lots
 - Roads
 - ~ Watercourses
 - Waterbodies

POA LOCATION DESCRIPTION
 Dutch Canyon Well
 Located 1,470 feet North and 1,820 feet East from the SW corner of Section 13, Township 3 North, Range 2 West (W.M.)

Claim of Beneficial Use
 in the Name of the City of Scappoose
 Place of Use/Point of Appropriation
 Permit G-8615, Application G-9218
 Township 3 North, Ranges 1 & 2 West (W.M.)

RECEIVED BY OWRD

JAN 27 2016

SALEM, OR
 COBU MAP 996

MAP NOTES:
 Date: December 22, 2015
 Data Sources: Columbia Co. GIS, OWRD, OGIC, US BLM, ESRI

