


Work copy  
3/29/02 NC

RECEIVED

MAY 24 2001

WATER RESOURCES DEPT.  
SALEM, OREGON

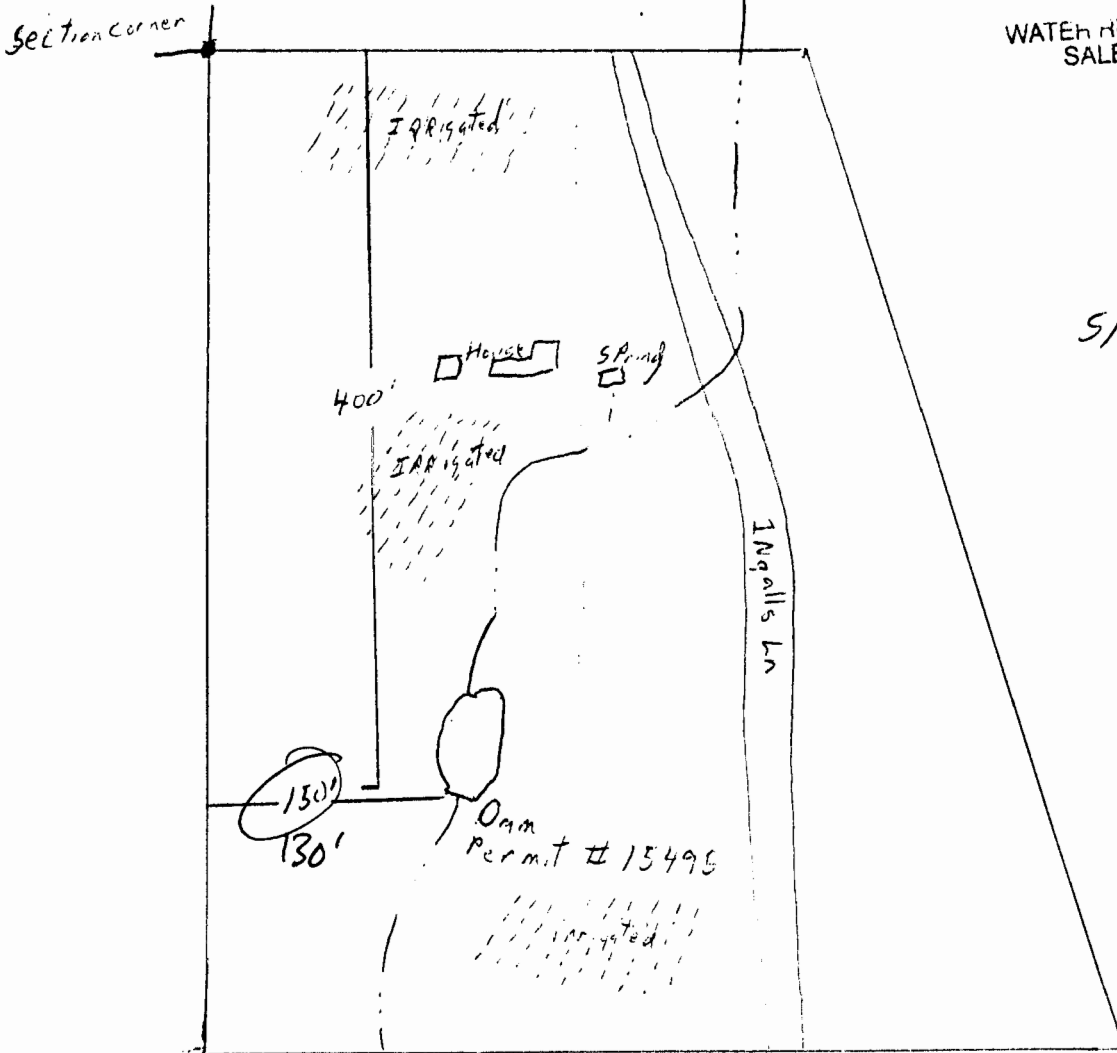

Spring Permit #  
19921

Application No. R 84758  
Permit No.

1" = 100'  
Sec. 1 T. 37 S R. 7 W  
Tax Lot 600