
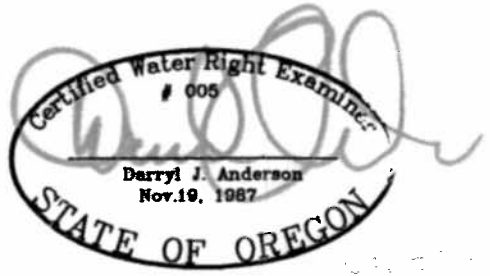


CLAIM OF BENEFICIAL
USE MAP

FOR

ROD HOAGLAND

SECTIONS 20, 21, 28 & 29, T38S R34E, W.M.
HARNEY COUNTY, OREGON

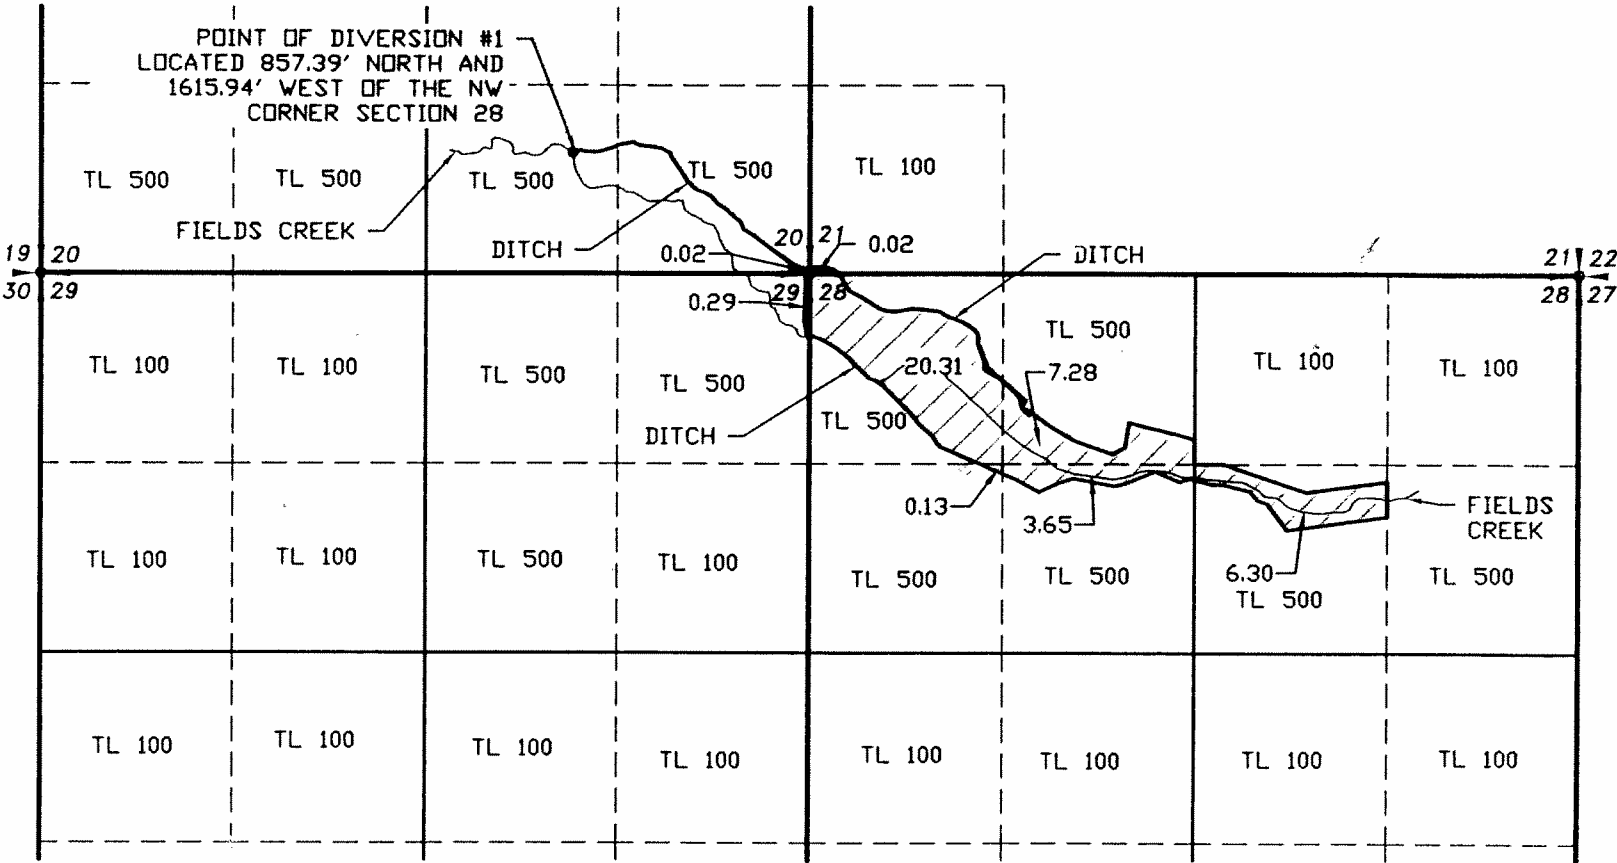

RENEWAL 12/31/13

- LEGEND**
- SECTION LINE
 - 1/4 SECTION LINE
 - 1/16 SECTION LINE
 - PLACE OF USE
38.0 ACRES



TRANSFER NO. T-11234

NOTE:
PREPARATION OF THIS MAP IS FOR IDENTIFYING PROPOSED
WATER RIGHTS ONLY. IT HAS NO INTENT TO PROVIDE
LOCATIONS OR DIMENSIONS OF PROPERTY BOUNDARIES.

SCALE: 1"=1320'

REVISION	BY

ANDERSON ENGINEERING
AND SURVEYING, INC.
P.O. BOX 28
LAKEVIEW, OREGON 97630
(541) 947-4407
FAX: 947-2321

FOR:
ROD HOAGLAND
22286 FIELDS DR
FIELDS, OR 97710
541-495-2329

CLAIM OF BENEFICIAL USE MAP
TRANSFER # T - 11234

DATE:	1-11-2013
SCALE:	1"=1320'
DWG. BY:	J.E.H.
JOB:	2012-051
FILE:	2012-051
SHEET:	1 OF 1

749