


CLAIM OF BENEFICIAL USE MAP


Application Nos. T-9801 -- Permit Nos. G-10005, G-12850, 47290 & 41864
 Section 13, T9S, R39E, WM -- Western Heights Subdivision -- Baker County, Oregon
 Powder River Basin

Tax Lot Nos. 9-39-13A, 1800 thru 3800; 9-39-13B, 200 thru 2200; 9-39-13C, 200; and 9-39-13D, 100 Thru 600

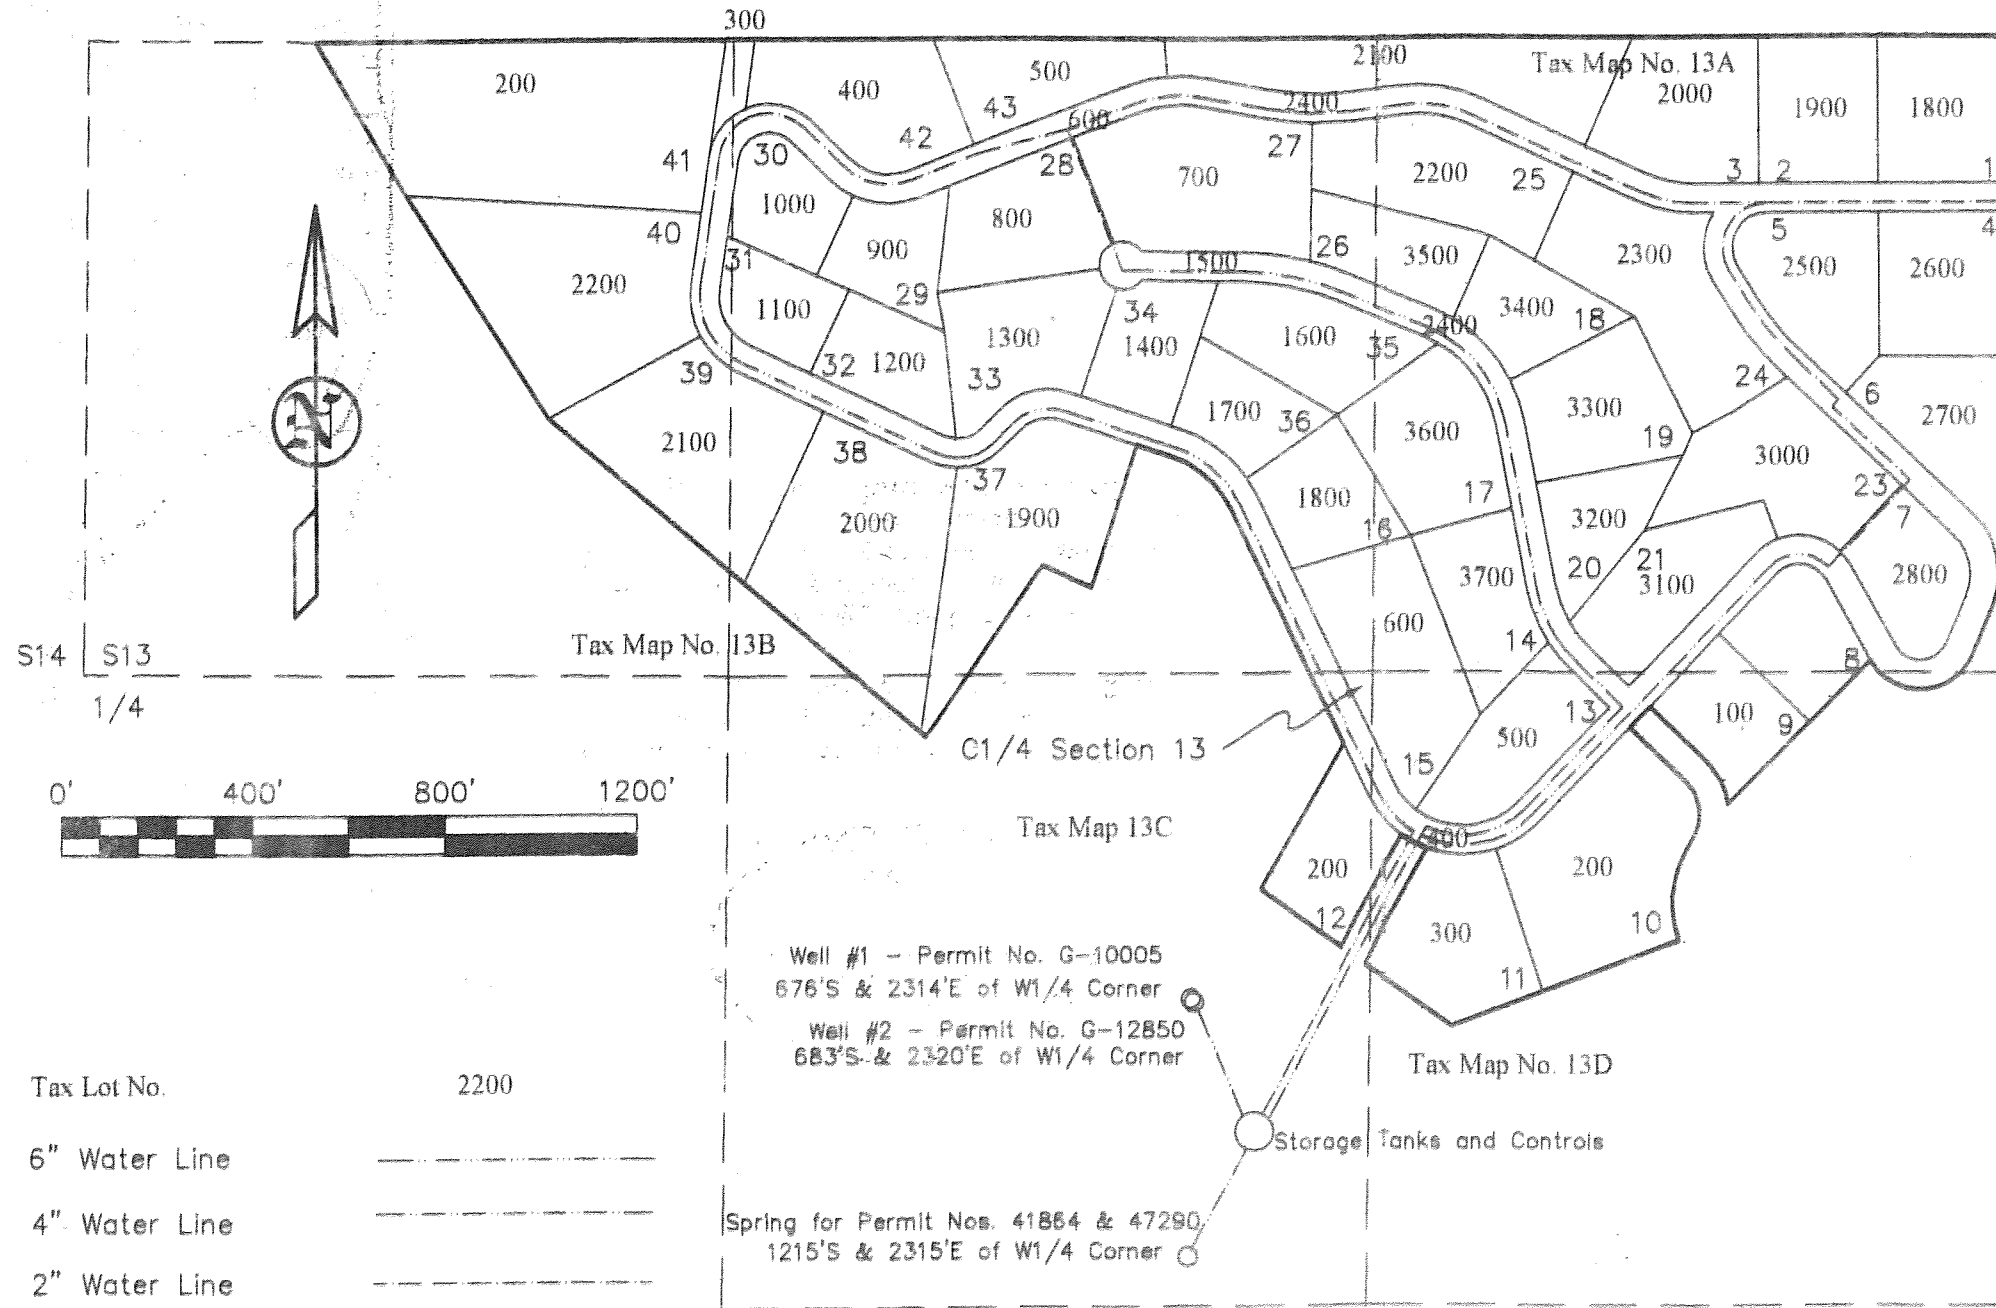

Transfer all four water rights with a variety of domestic uses to a Quasi-municipal use for the entire Western Heights subdivision by Western Heights Homeowners Association, Inc., a water supplier as defined in ORS Chapter 448.

This map is for the purpose of identifying the location of the water right only and has no intent to provide dimensions or location of property ownership lines.

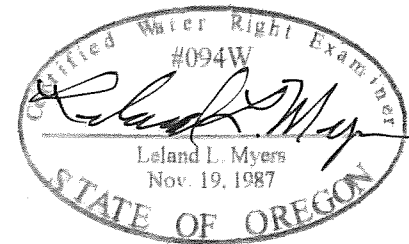

COBU MAP # 0625
 folder 11