


RECEIVED

OCT 19 1999

TOWNSHIP 6 SOUTH, RANGE 1 EAST, W.M.


WATER RESOURCES DEPT
SALEM, OREGON

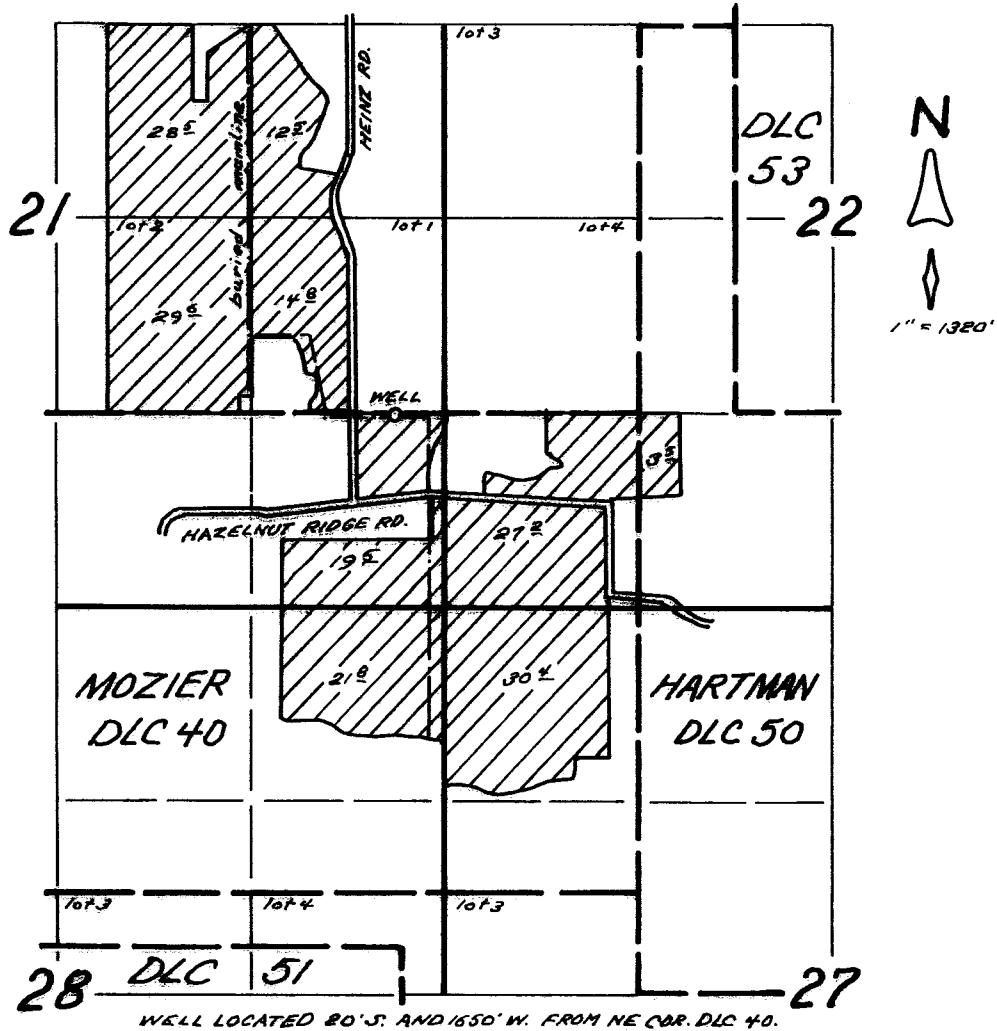

FINAL PROOF SURVEY
 UNDER
 APPL. No. G-13719, PER. No. G-12959
 IN NAME OF

DAVID J. BIELENBERG

OCT. 6, 1999

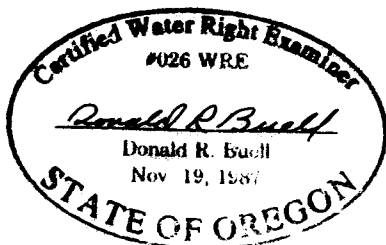

THIS MAP WAS PREPARED FOR THE PURPOSE OF IDENTIFYING THE LOCATION OF A WATER RIGHT ONLY AND IS NOT INTENDED TO PROVIDE LEGAL DIMENSIONS OR LOCATION OF PROPERTY OWNERSHIP LINES.

This map has been revised by WRD for identifying the well location only. Use the final proof survey for Permit S-53 to identify the date of use. 11/1/99