


Section 29, T3N, R36E, WM
Umatilla County


1 inch = 400 feet

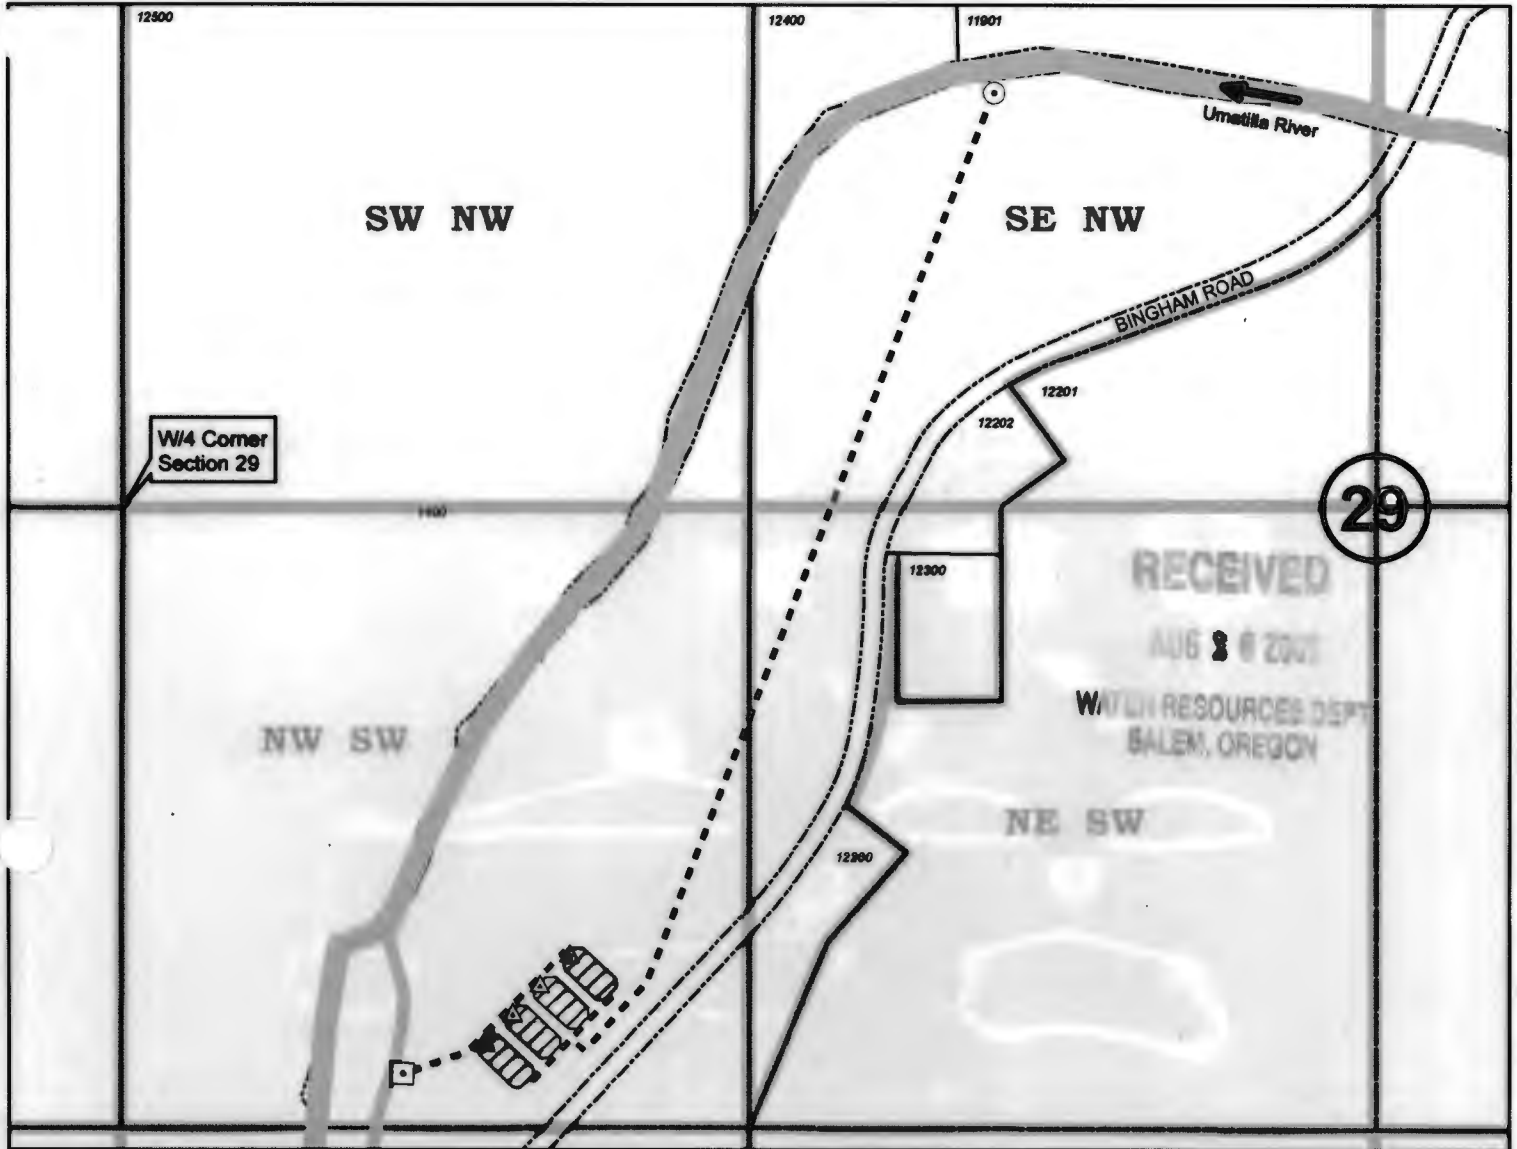

- Point of Diversion**
 Gravity diversion in SE/4 of NW/4 of Section 29, at a location 865 feet N and 795 feet W from Center of Section 29. Fish screen at same location.
- Conveyance**
 Water conveyed from POD to ponds with buried, gravity-fed, 30-inch HDPE pipeline, and from ponds to outfall with four parallel, buried, gravity-fed 24-inch HDPE pipelines.
- Place of Use**
 Water used for fish acclimation in four ponds located in Tax Lot 12500 in NW/4 SW/4 of Section 29, T3N, R36E, WM.
- Weirs**
 Flow measurement weirs located at pond outlets.
- Outfall**
 Pond effluent returns to Umatilla River 2,600 feet downstream from POD.

The purpose of this map is to identify the location of a water right. It is not intended to provide information regarding the location of property ownership boundaries.

FOUNTAINHEAD
 1204 Alvarado Terrace
 Walla Walla, WA 99362
 509.529.2646 phone

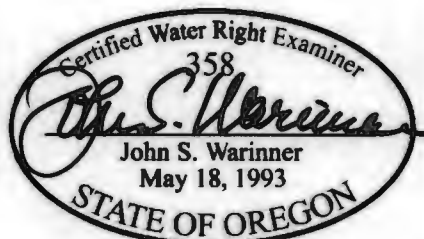

CLAIM OF BENEFICIAL USE
App S-73764 Permit 53644

in the name of
BONNEVILLE POWER ADMIN

Revised 18 JUN 2009