


app # R-84922
Permit # 13206



RECEIVED

SEP 21 2001

WATER RESOURCES DEPT.
SALEM, OREGON

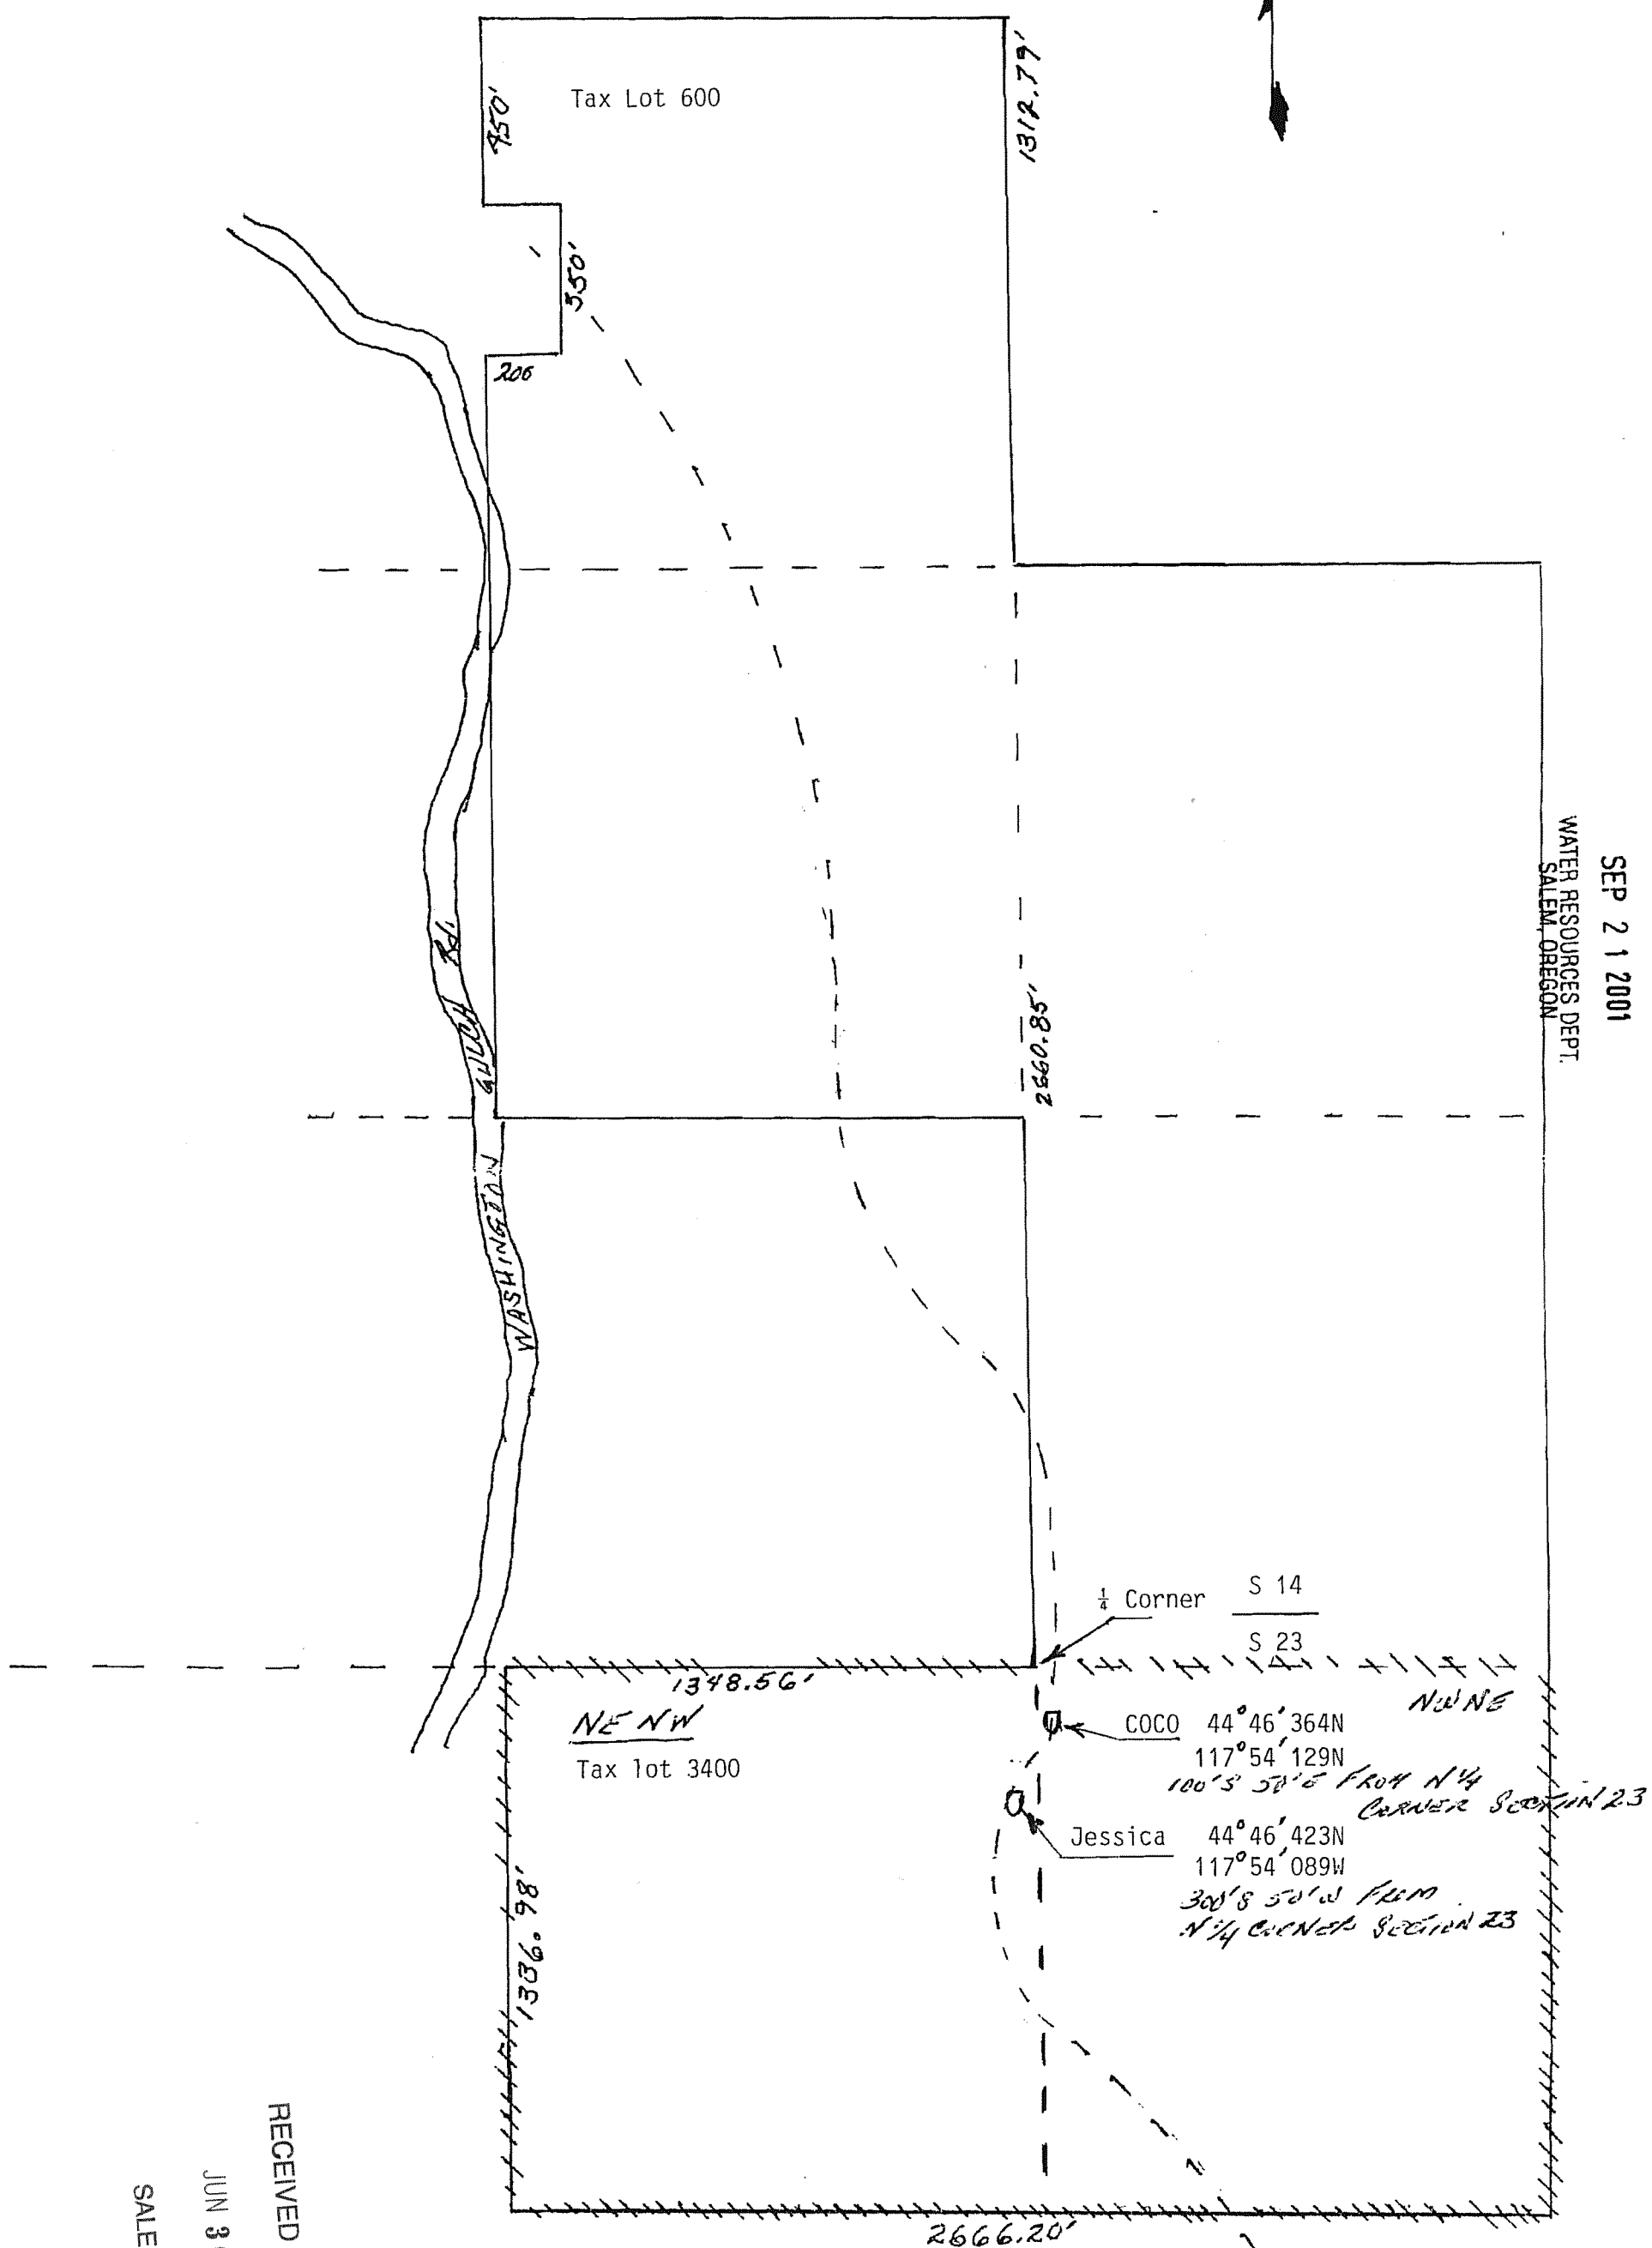

SCALE: 1" = 400'

RECEIVED BY OWRD

JUN 30 2015

SALEM, OR