


[illegible]

 Area (^{32.0}~~33.4~~ acres) to be supplemental to acreage irrigated under contract with the Tualatin Valley Irrigation District (TVID); *Certificate 88122*

Area (63.2 acres) to be supplemental to acreage irrigated by excess, non-contracted water normally made available by the TVID, or to become primary in the event that water is not delivered by TVID.

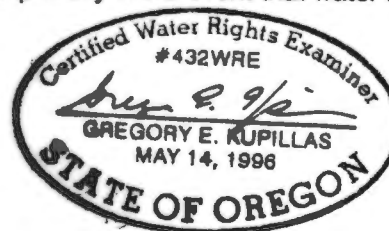

EXPIRATION DATE: 6/30/02

Scale: 1" = 1,320'

0 1,320
Feet

This map was prepared for the purpose of identifying the location of a water right only and is not intended to provide legal dimensions or location of property ownership lines

Quail Valley Golf Corporation
T.2N. R.3W. Section 31

Pacific Hydro-Geology Inc.

5-12-16

Map revised by WRD to reflect area in regards to underlying right. ^{nfb}
~~wro~~