


**T5S R23E TL 2400
Lone Rock Rd. Pond #1 Permit R-14656**

1 inch = 1,320 feet

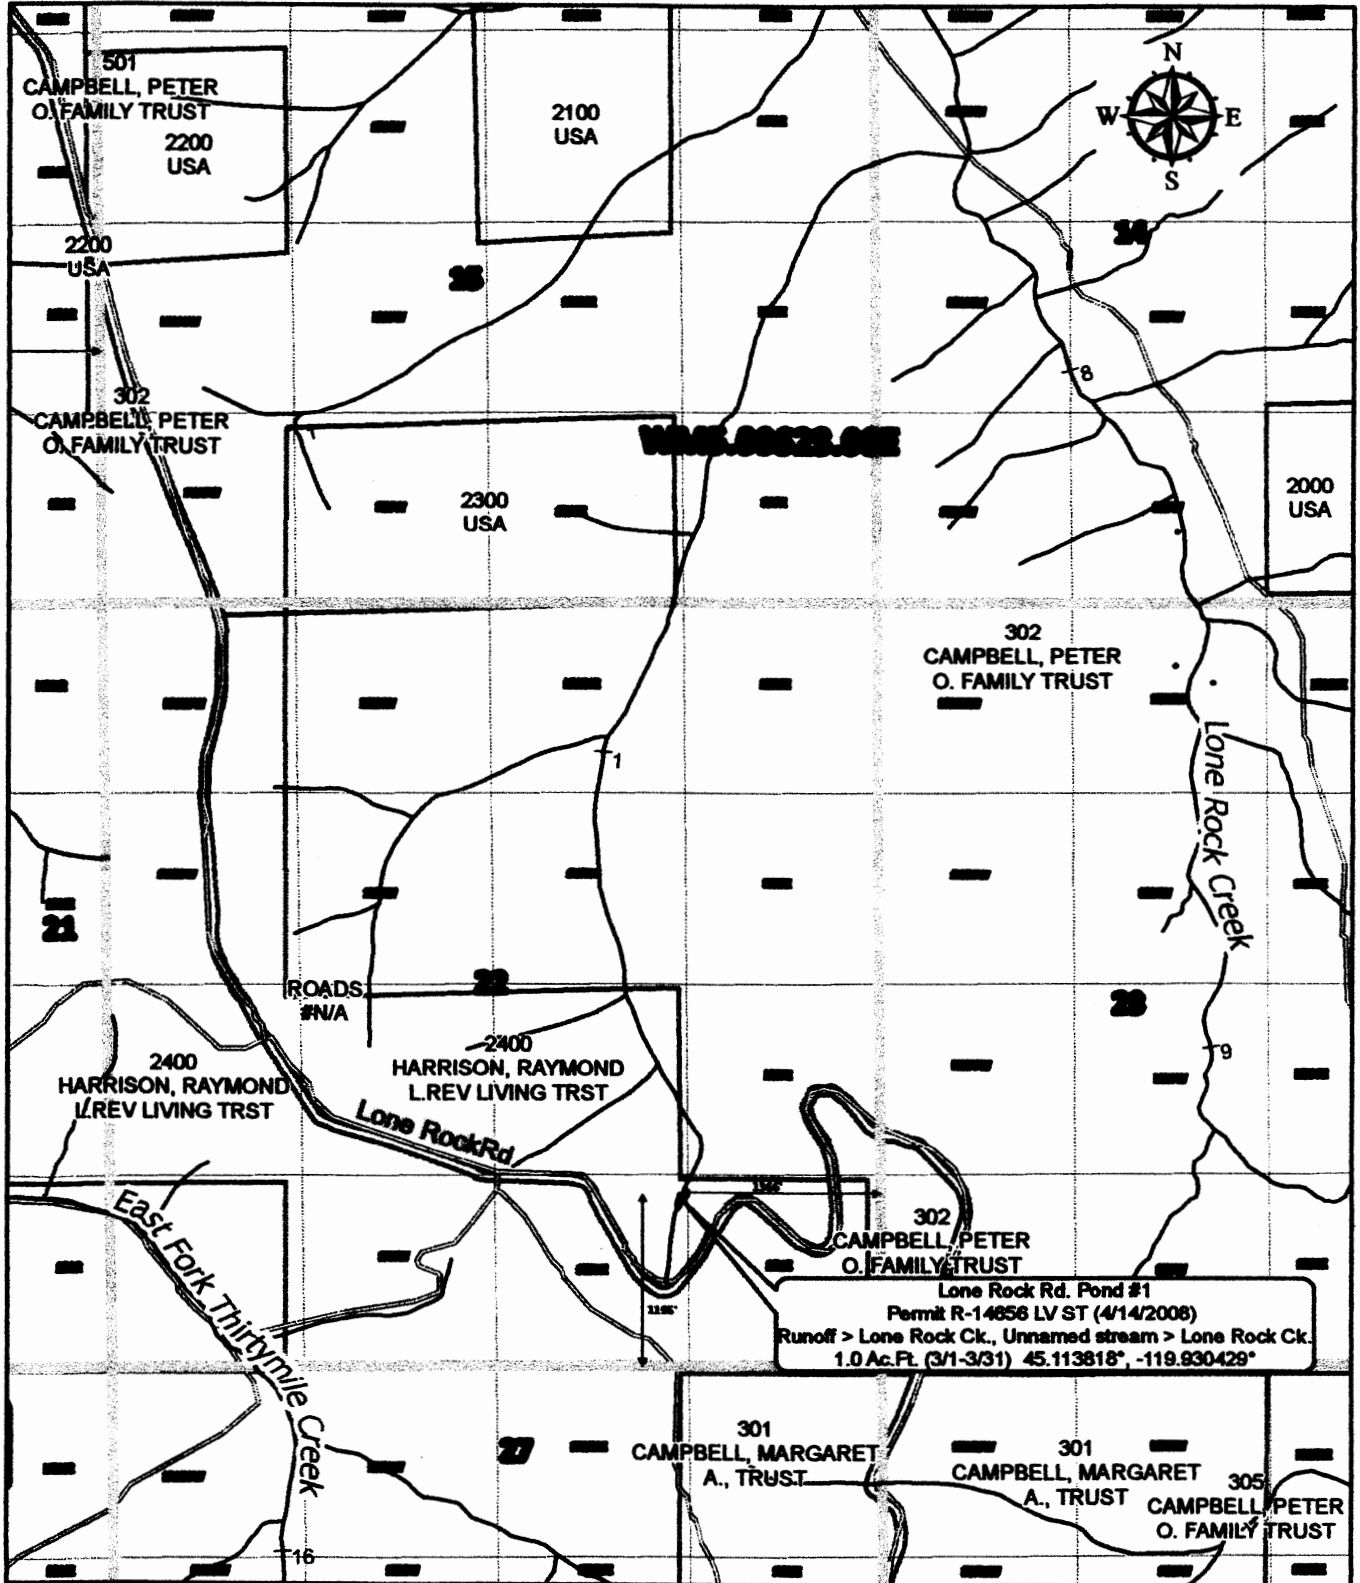

**Lone Rock Rd. Pond #1
5.00S-23.00E-22-SW SE
1195' N, 1366' W from SE Cor., Sec. 22**

RECEIVED BY OWRD

RECEIVED BY OWR

JUL 01 2015

JUL 16 2015

SALEM, OR

SALEM, OR