


T10 & 11S, R6W, W.M.

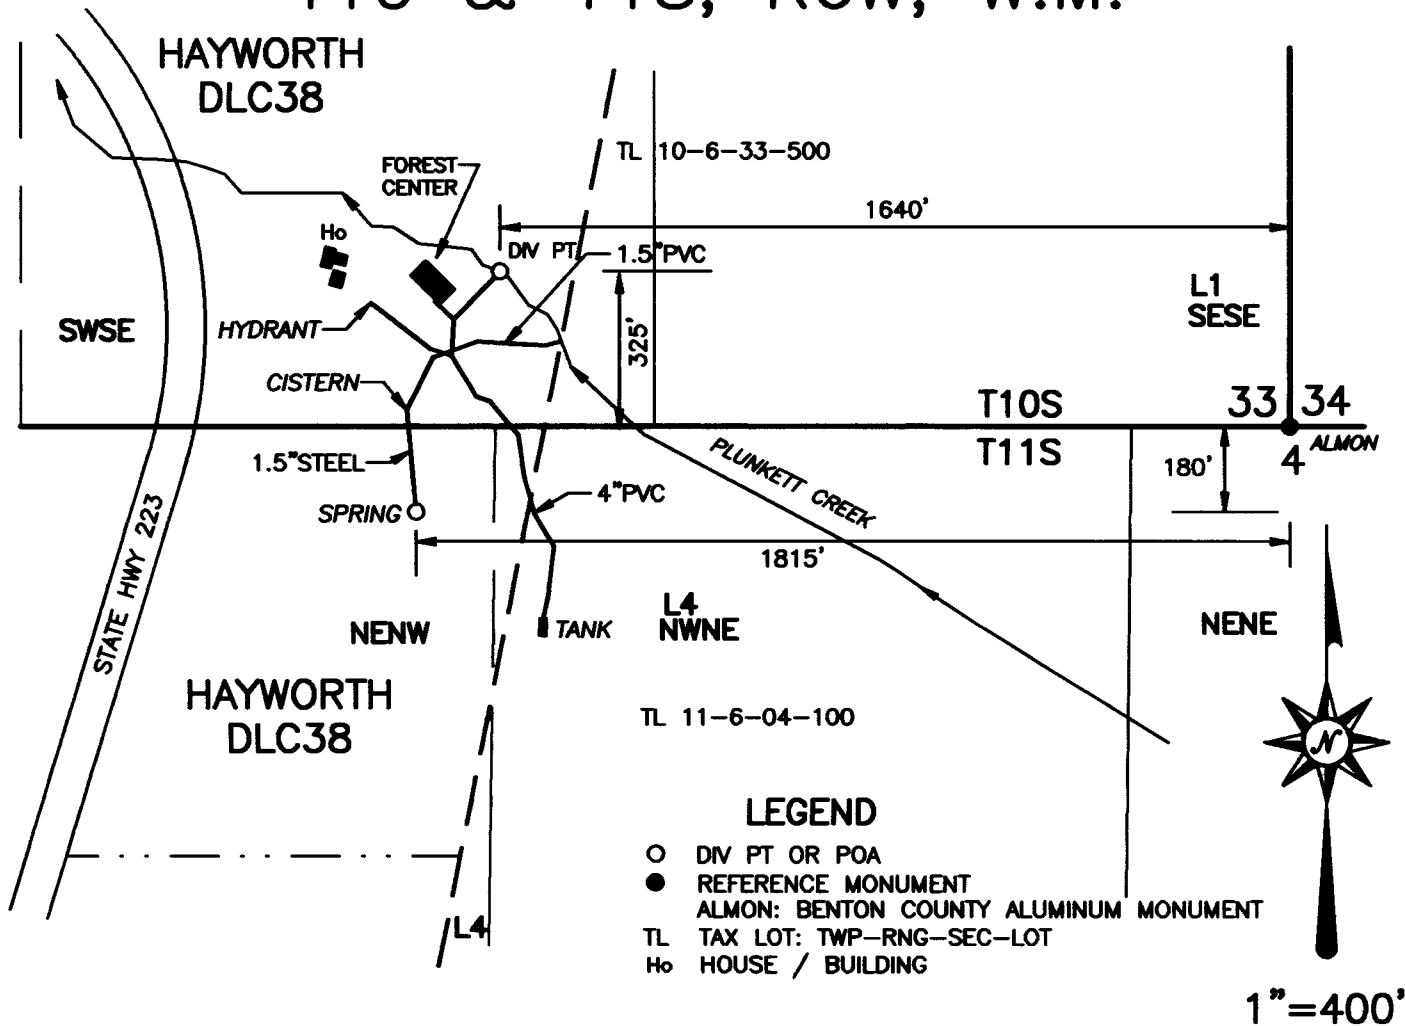

CLAIM OF BENEFICIAL USE MAP

IN THE NAME OF

Benton County Natural Areas and Parks Dept. Transfer T-10773

SPRING: 180 FT SOUTH AND 1815 FT WEST OF THE
SOUTHEAST CORNER SEC 33, T10S R6W. W.M.
DIV PT: 325 FT NORTH AND 1640 FT WEST OF THE
SOUTHEAST CORNER SEC 33, T10S R6W. W.M.

BEARINGS BY SOLAR OBSERVATION. CORNER & MAPPING
INFORMATION FROM BENTON COUNTY SURVEYOR'S OFFICE.
THE FOREST EDUCATION CENTER (FEC) IS LOCATED IN
THE RECONSTRUCTED BARN.


NO FISH SCREEN REQUIRED
NO METER REQUIRED

Prepared 1/27/2013
PARSONS SURVEYING
1915 S.E. Stone St.
Corvallis, OR 97333
541-752-7515
Project No. 1222

RECEIVED BY OWRD

MAR 18 2013

SALEM, OR

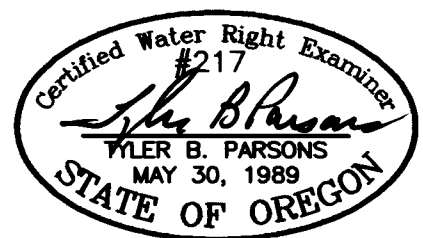

THIS MAP IS NOT INTENDED TO PROVIDE LEGAL DIMENSIONS
OR LOCATIONS OF PROPERTY OWNERSHIP LINES

RENEWS: 12/31/2014