



T. 40 S., R. 14-1/2 E., W.M.
KLAMATH COUNTY, OREGON

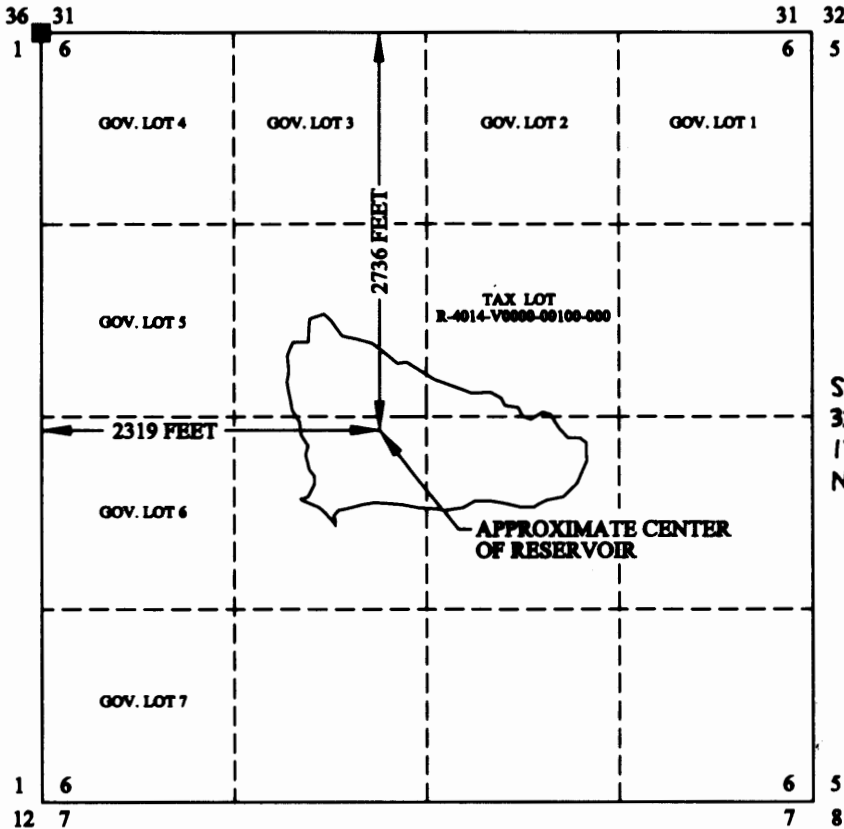

1952 GLO BRASS CAP
NW CORNER OF
SECTION 27



SPILLWAY LOCATION:
3207 FEET SOUTH AND
1775 FEET EAST FROM
NW CORNER, SECTION 6

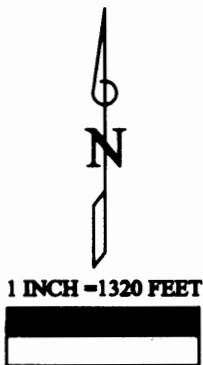

CLAIM OF BENEFICIAL USE MAP

FOR

UNNAMED RESERVOIR 40S 14-1/2E

APPLICATION: R-83425

PERMIT: R-12740

IN THE NAME OF

UNITED STATES BUREAU OF LAND MANAGEMENT

LAKEVIEW DISTRICT


DECEMBER 9, 2014

RECEIVED

JAN 28 2015

OWRD

THE PURPOSE OF THIS MAP IS FOR IDENTIFYING THE LOCATION
OF THE WATER RIGHT ONLY AND IS NOT INTENDED TO PROVIDE
LEGAL DIMENSIONS OR LOCATIONS OF PROPERTY
OWNERSHIP LINES.

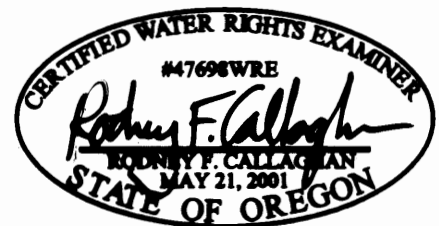

RENEWAL: 12/31/2015

U.S. BUREAU OF LAND MANAGEMENT - OSO

BRANCH OF CADASTRAL SURVEY

DATED: DECEMBER 22, 2014

EXECUTED BY:

RODNEY F. CALLAGHAN, PLS, CWRE

DAVID CHRISS, PLS

1301 SOUTH G STREET

LAKEVIEW, OR 97630