


TOWNSHIP 18 SOUTH, RANGE 21 EAST, W.M.

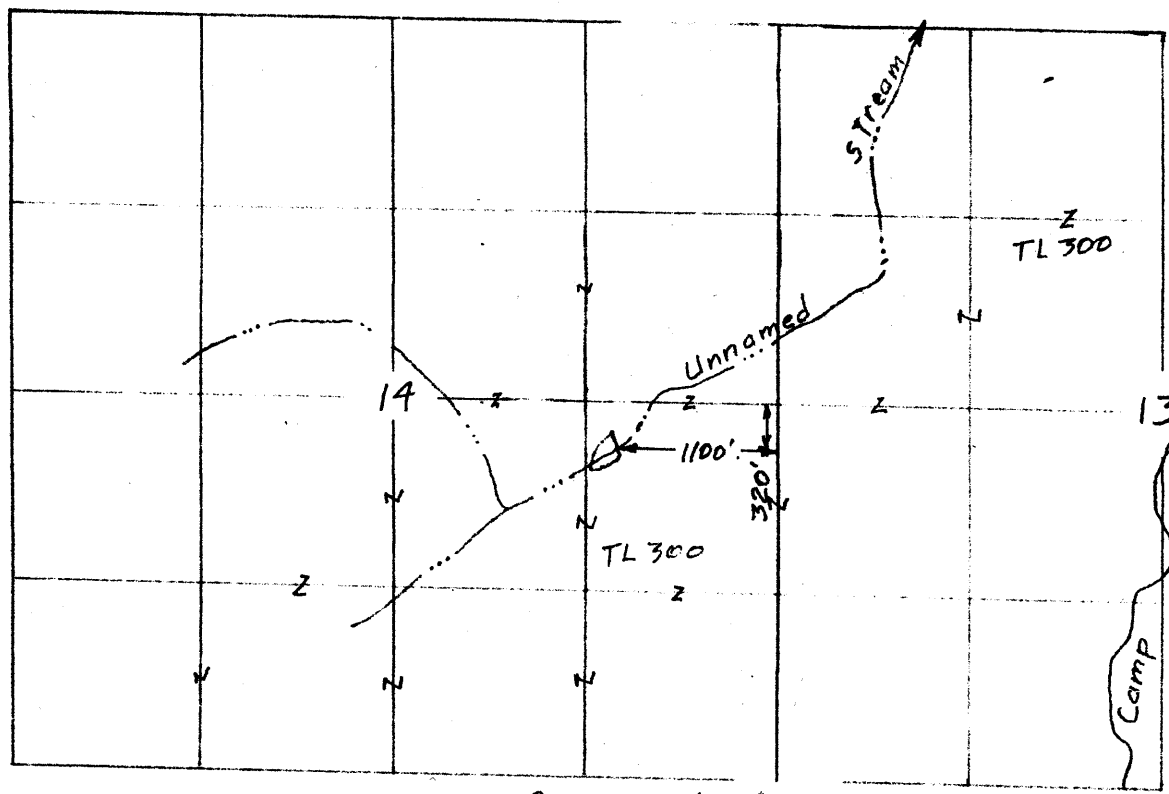

Scale  
1" = 1320'  
(4" = 1 mile)



Surveyed March 8, 2012

App R-86582  
Per R-14312


Claim of Beneficial Use Map  
for  
OREGON RANCHING CO.  
(Twin Buttes Ranch)

**RECEIVED**

FEB 19 2016

WATER RESOURCES DEPT  
SALEM, OREGON

This map is for the purpose of  
locating a water right only  
and has no intent to provide  
legal dimensions or the location  
of property lines.

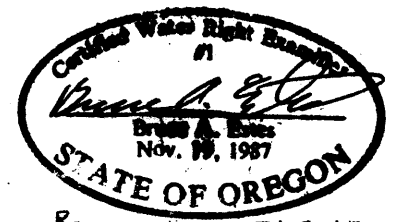

Renewal Dec 31, 2017  
amended Feb 10, 2016

**ESTES SURVEYS, LLC**  
PO-Box 17546      60382 Arnold Rd  
Salem, OR 97325-7546      Bend, OR 97702  
(503) 366-7888      (541) 382-7301