
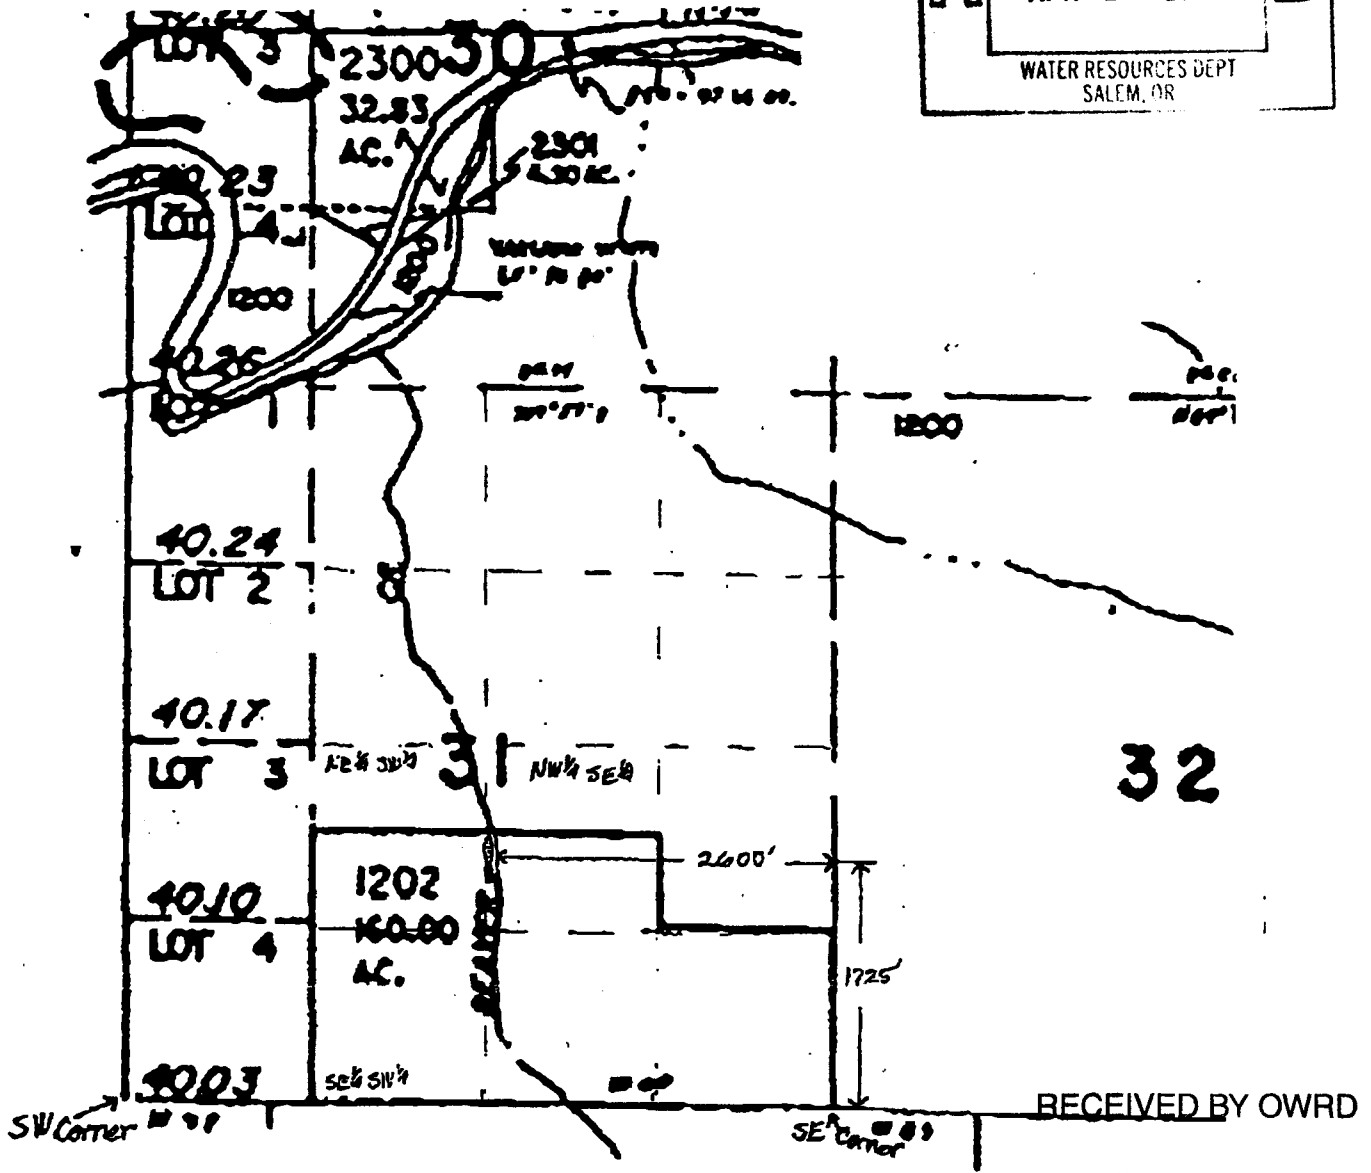


Township 3 South Range 36 East

Section 31 Tax lot 1202

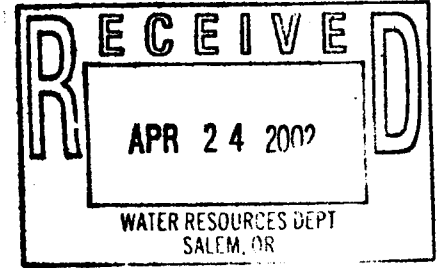

Scale 1" = 1320' (4" = 1 mile)

Application R-85004
Permit R-13313

RESERVOIR LOCATION
45° 15.424' N.
118° 21.368' W.
RECEIVED BY OWRD

RECEIVED BY OWRD JUN 22 2015

JUL 06 2015

SALEM, OR

SALEM, OR