


FINAL PROOF SURVEY CLAIM OF BENEFICIAL USE

TRANSFER NO. T-8743
IN THE NAME OF KATHLEEN DEGGENDORFER AND GERTRUDE BOYLE

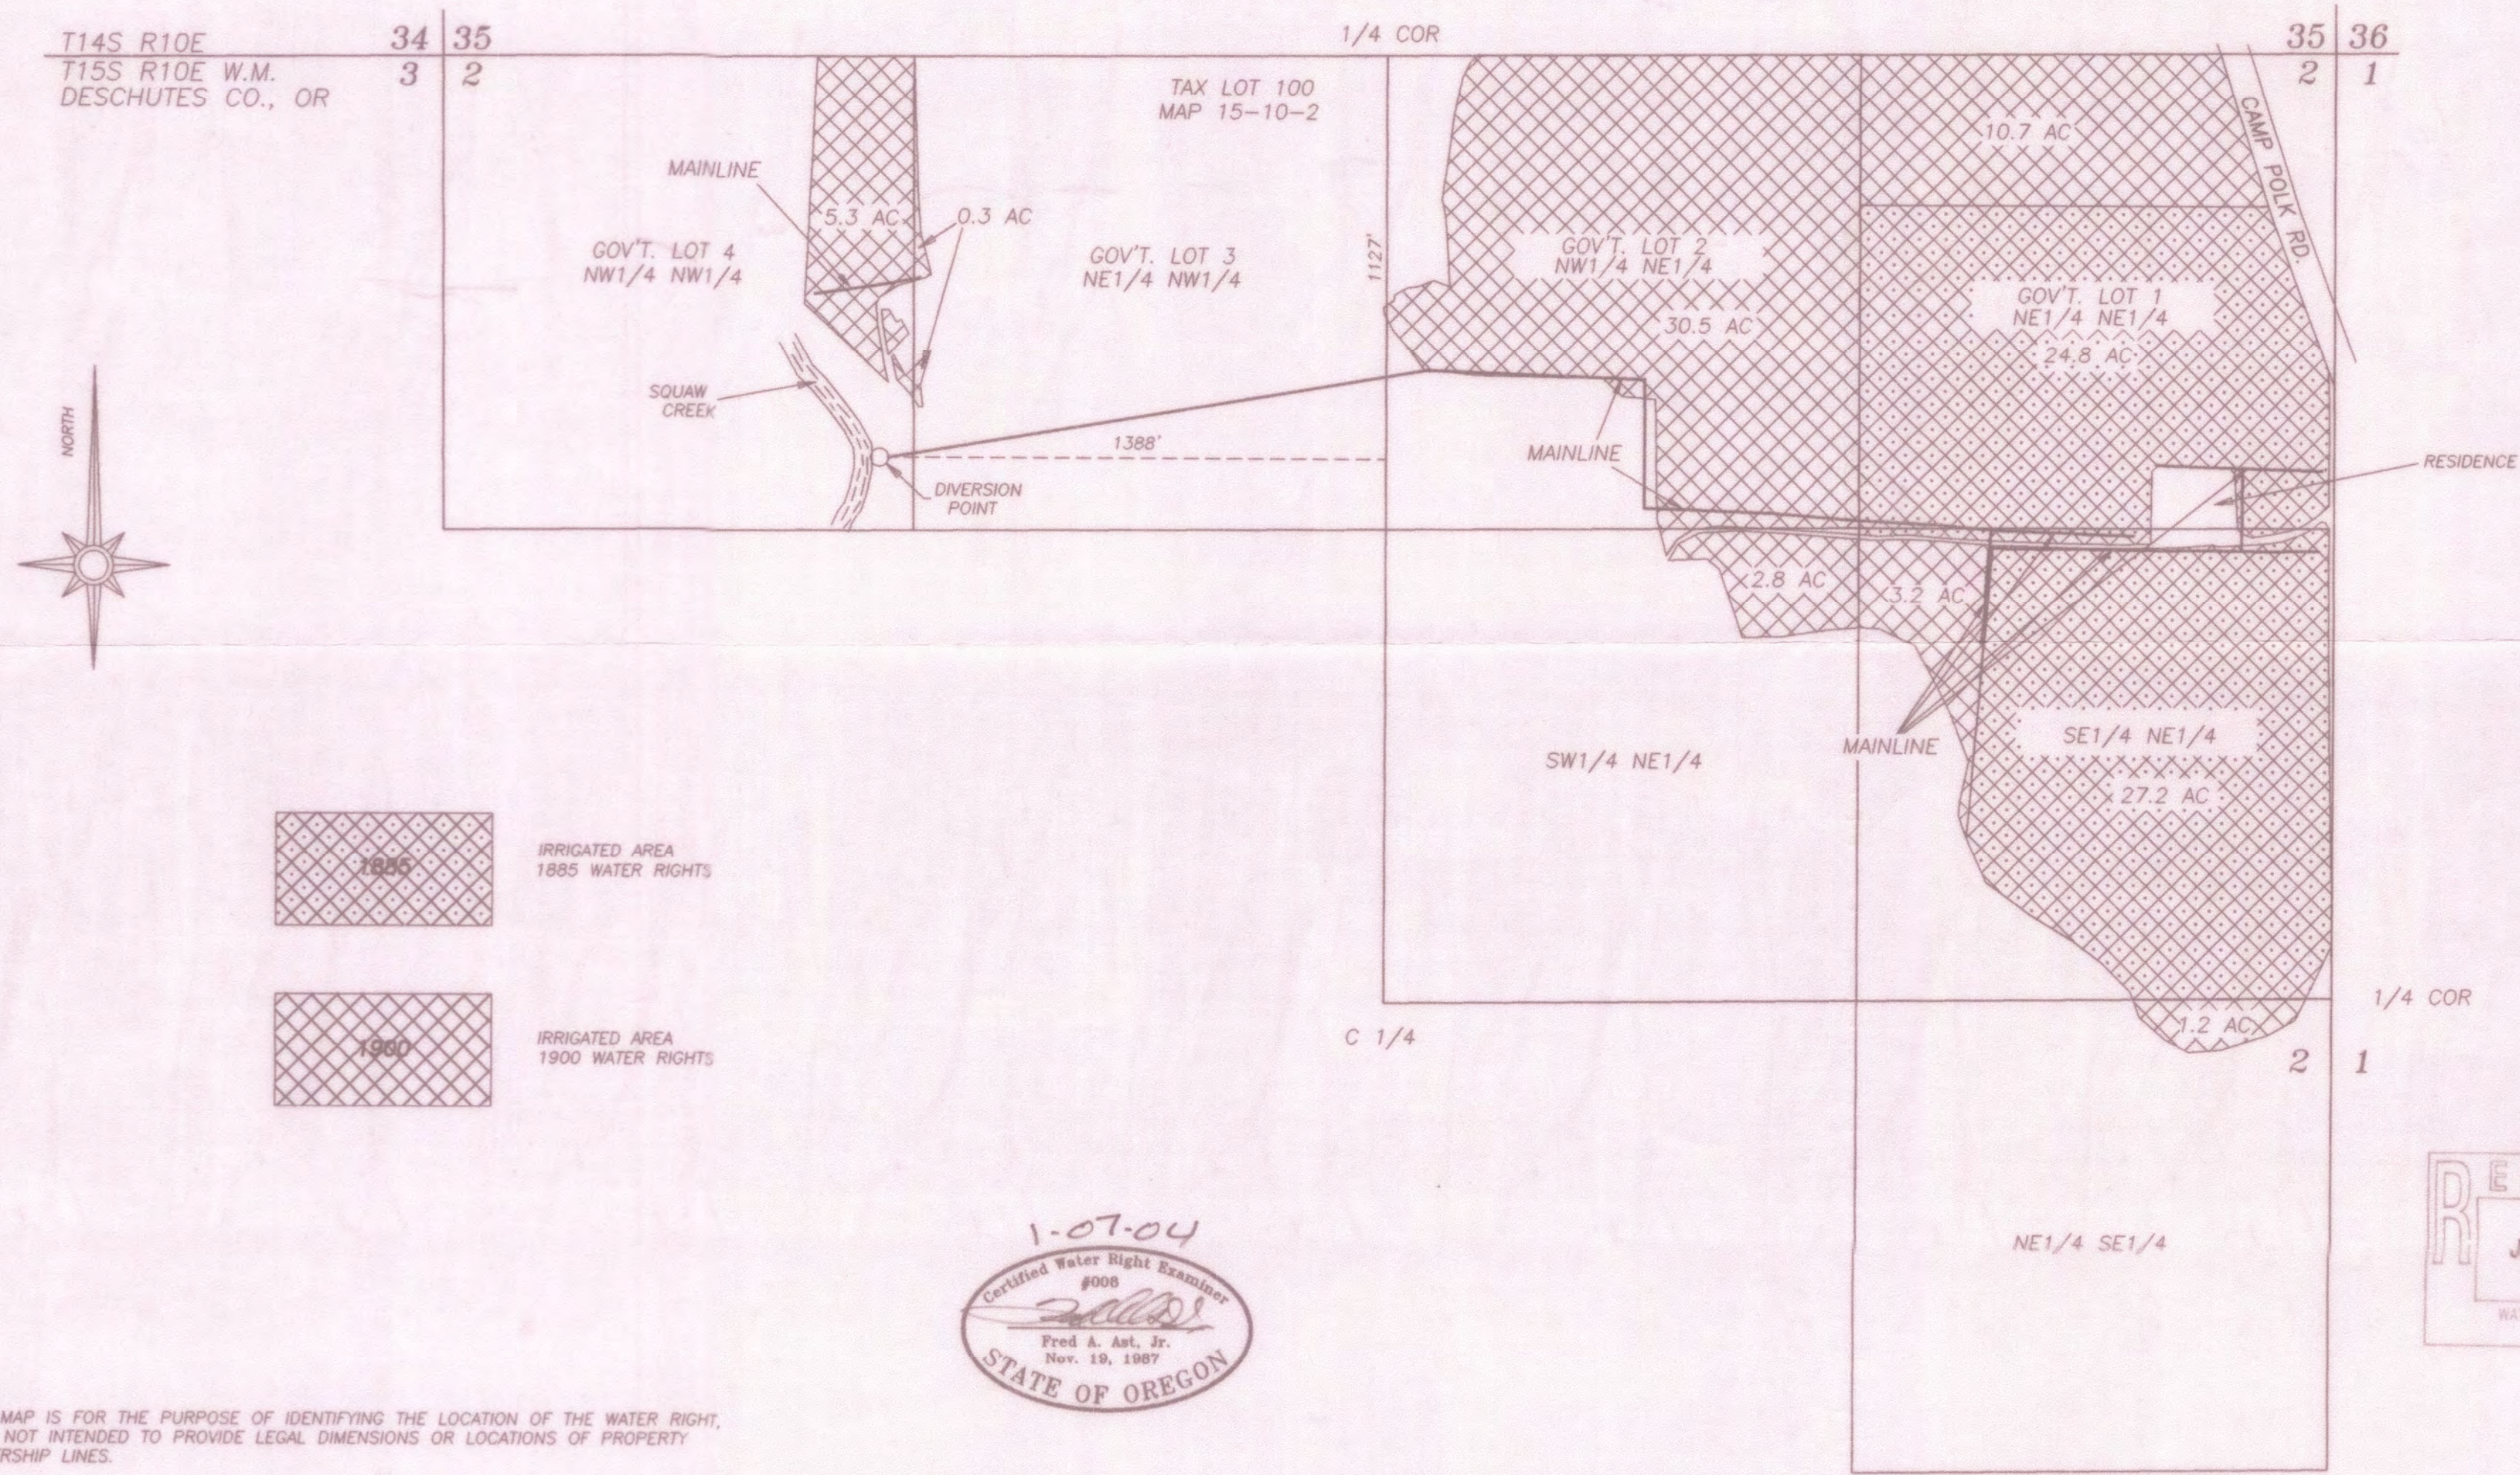

THIS MAP IS FOR THE PURPOSE OF IDENTIFYING THE LOCATION OF THE WATER RIGHT, IT IS NOT INTENDED TO PROVIDE LEGAL DIMENSIONS OR LOCATIONS OF PROPERTY OWNERSHIP LINES.

1-07-04
Certified Water Right Examiner
#000
Fred A. Ast, Jr.
Fred A. Ast, Jr.
Nov. 19, 1987
STATE OF OREGON

RECEIVED
JAN 26 2004
WATER RESOURCES DEPT
SALEM, OR

Fred A. Ast, Jr. and Associates 250 West Cascade P.O. Box 751 Sisters, Oregon 97759 541-549-7851

COBU MAP # 0122

0122