
Revised

T.5S. R.1E. Sec. 18, 19 & 20

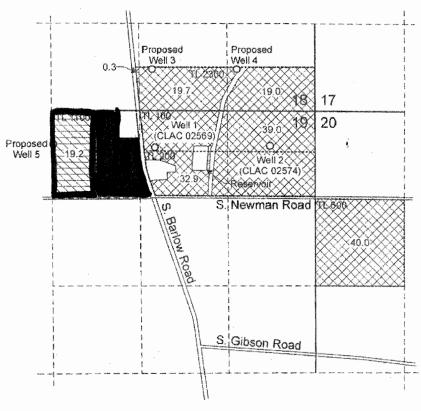

Authorized Well 1 (CLAC 02569) is located 570 feet south and 2,420 feet west from the NE corner of Section 19. Authorized Well 2 (CLAC 02574) is located 530 feet south and 670 feet west from the NE corner of Section 19. Proposed Well 3 is located 630 feet north and 2,460 feet west from the SE corner of Section 18, Proposed Well 4 is located 630 feet north and 1,180 feet west from the SE corner of Section 18. Proposed Well 5 is located 490 feet south and 3,950 feet west from the NE corner of Section 19,

Primary irrigation of 150.9 acres under Application G-6144, Permit G-5164, Certificate 44142.

rimary irrigation of 19.2 acres under Application G-6793, Permit G-6083, Certificate 44143.

Supplemental irrigation of 170.1 acres under Application G-7277, Permit G-6711, Certificate 51883.


Remaining Rights under Certificates 44142 and 44143

RECEIVED

JUL 2 7 2006

WATER RESOURCES DEPT SALEM, OREGON

Rvsd. 7/2006

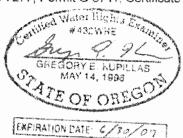

Scale: 1" = 1,320'



This map was prepared for the purpose of identifying the location of a water right only and is not intended to provide legal dimensions or location of property ownership lines.

Map to Accompany a Water Right Transfer

Leo Gentry Wholesale Nursery, Inc. T.5S. R.1E. Sec. 18, Tax Lot 2300; Sec. 19, Tax Lots 100, 200, and 1100; and Sec. 20, Tax Lot 600

Pacific Hydro-Geology Inc.