


FINAL PROOF SURVEY MAP

IN THE NAME OF Donald & Debra Doerfler

TRANSFER T-8846

T 7 S, R 1 W, W.M. Section 34

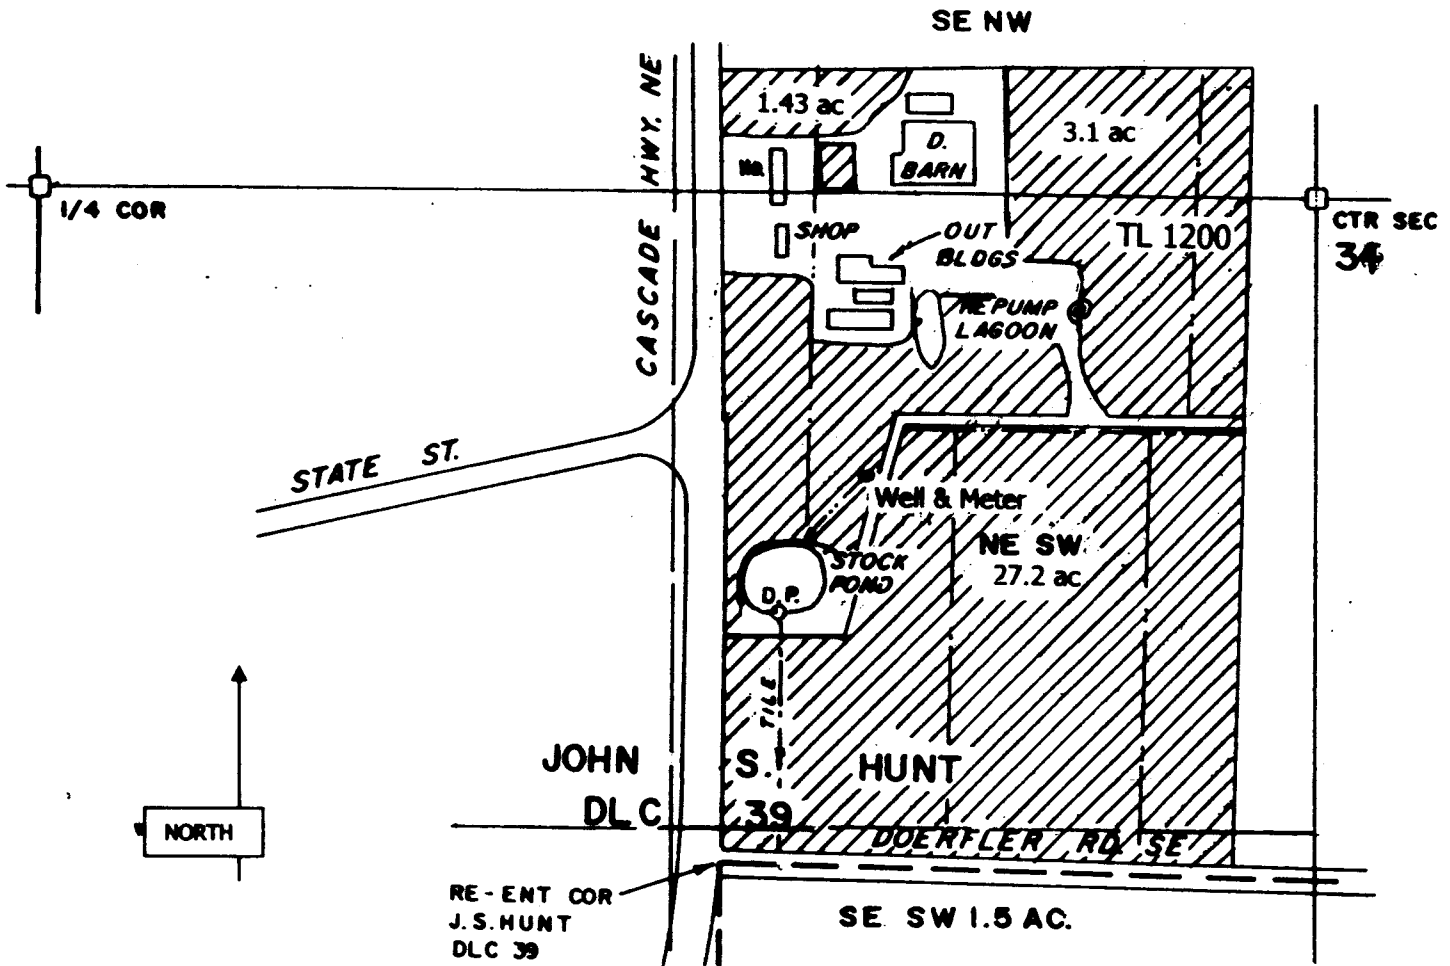

Well: 810' N & 290' E of the re-entry corner DLC 39
Pond: 520' N & 130' E of the re-entry corner DLC 39

RECEIVED
DEC 07 2006
WATER RESOURCES DEPT
SALINA, OREGON

Scale 1" = 400'



This map is not intended to provide legal dimensions or locations of property ownership lines .

RENEWAL DATE: 6-30-2007