


T.20S.R.22&23E.W.M.

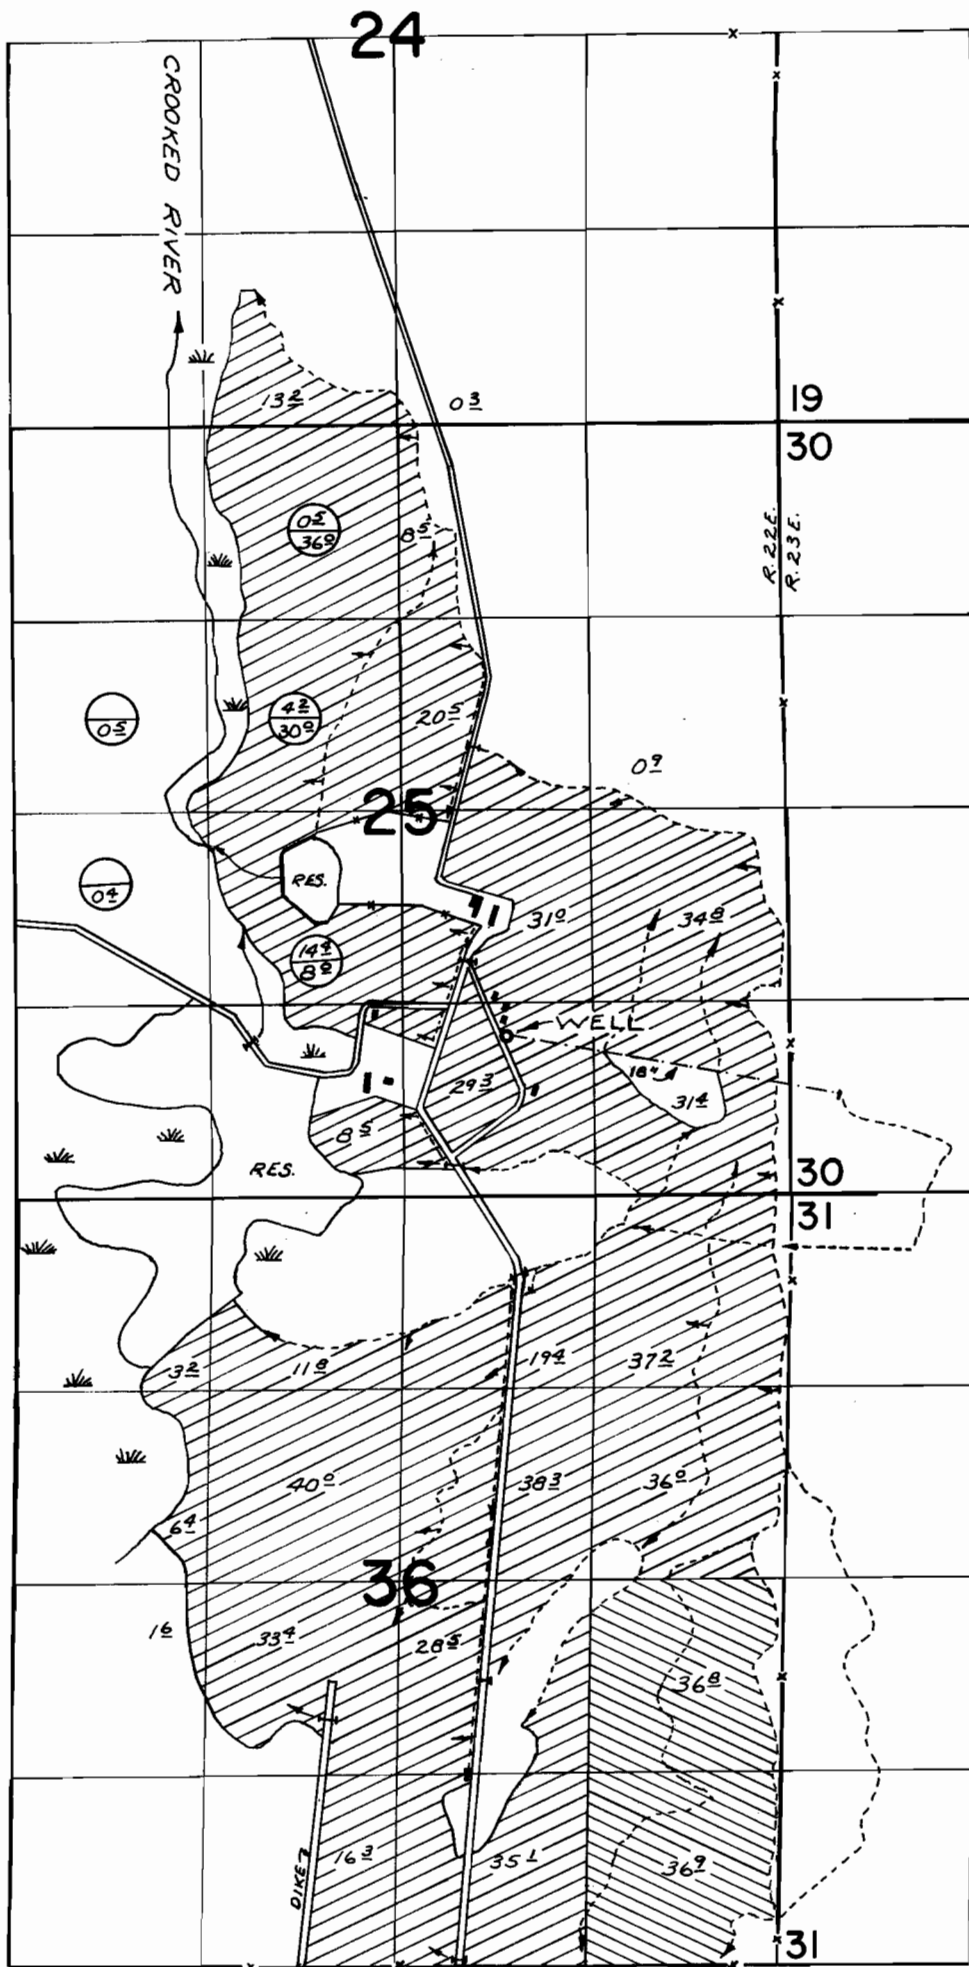

⊖ PRIMARY  
 ⊕ SUPPLEMENTAL

WELL LOC: 6380'N & 1940'W. FROM S.E. COR. SEC. 31

FINAL PROOF SURVEY

UNDER  
 G-5408

G-5208


Application No. G-2608 Permit No. G-2422




IN NAME OF

G. I. RANCH

Surveyed JULY 11, 1974., by R. MUCKEN

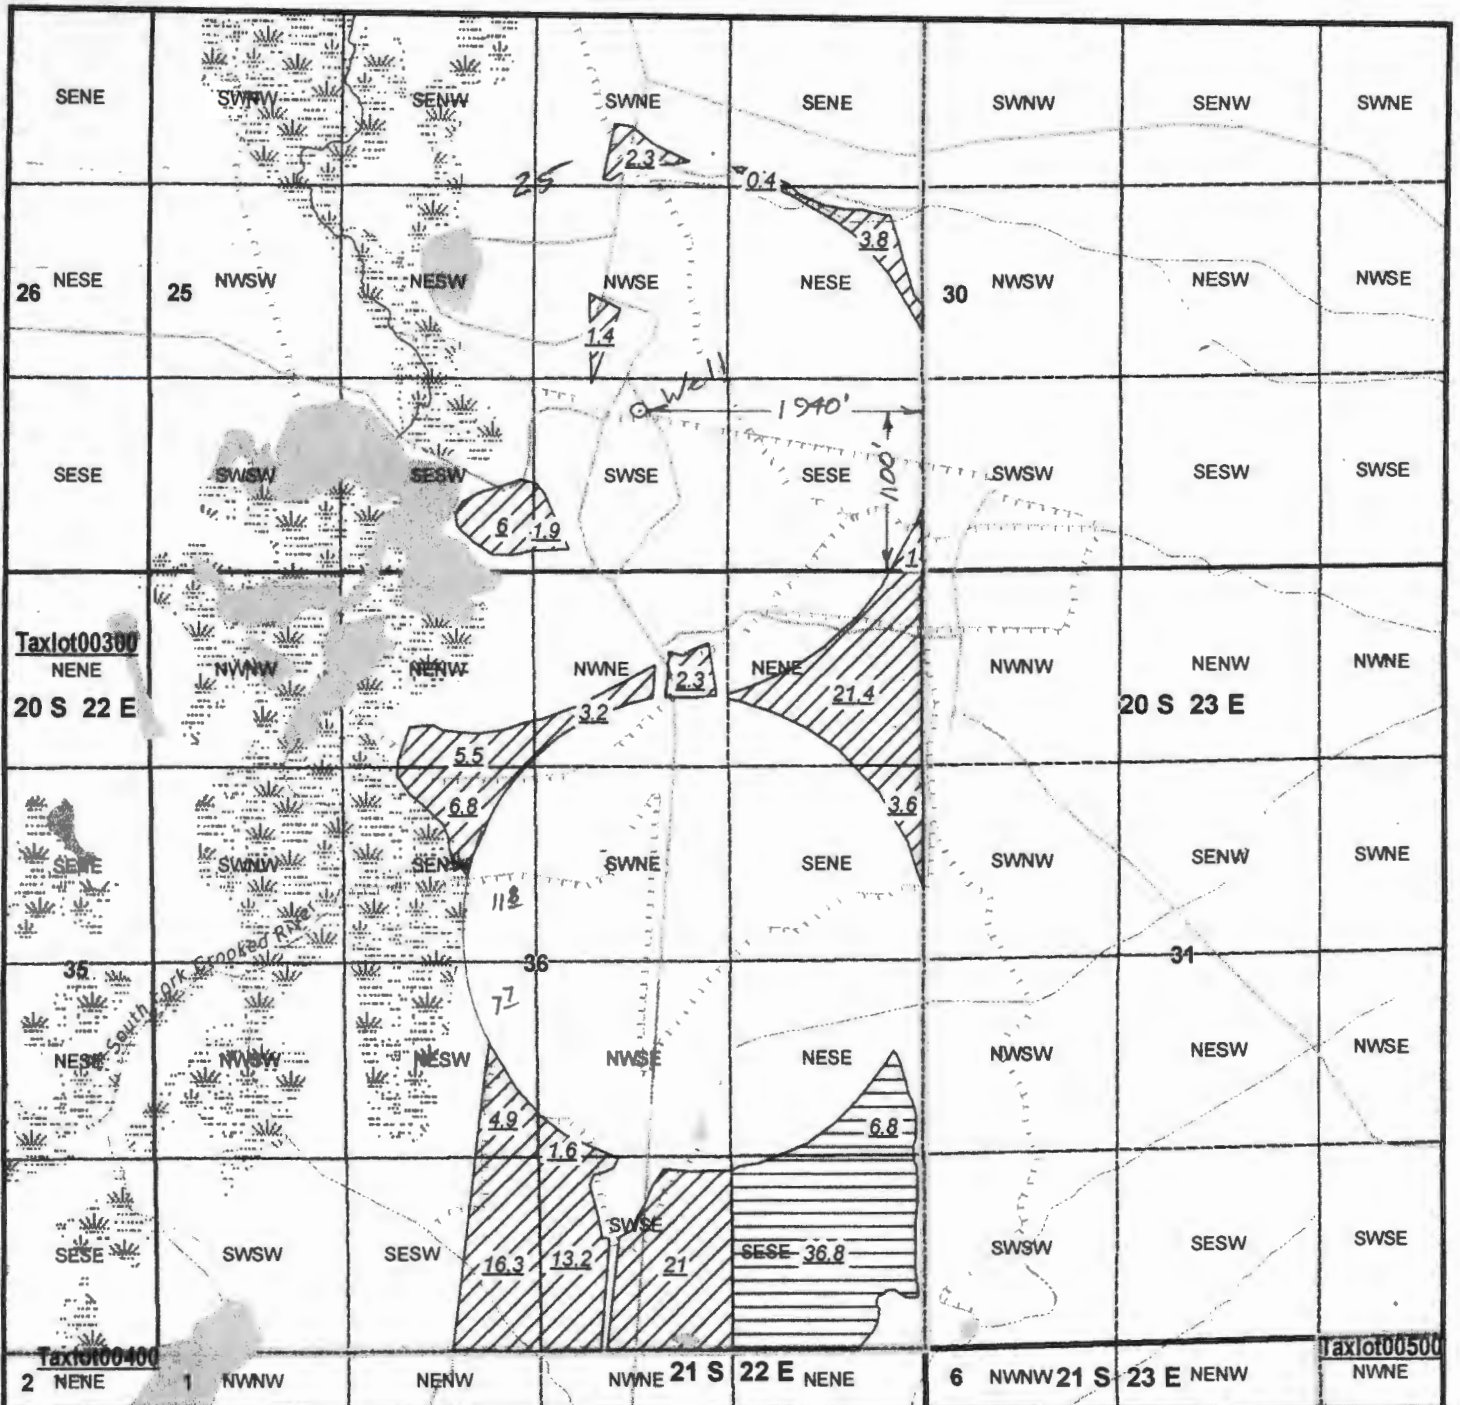

**Groundwater Transfer Application for 160.2 acres**  
**GI Ranch Corporation**  
**Crook County, OR**

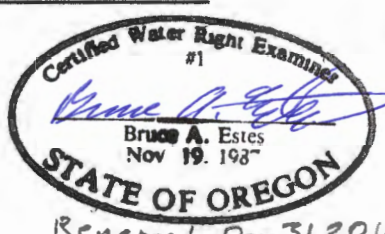

(F-5)

This map is for the purpose of locating a water right only and has no intent to provide legal dimensions or the location of property lines.

Map Disclaimer: This product is for informational purposes and may not have been prepared for, or be suitable for legal, engineering, or surveying purposes. Users of this information should review or consult the primary data and information sources to ascertain the usability of the information. This map is not intended to display property lines.

Disclaimer: This listing is the result of a manual search of the records of the Watermaster's Plat Cards and the WRE database. The listing has not been field checked. That a right is of record is no guarantee that it has not been abandoned under the conditions of ORS 542.010. The plat card records of land by the 40.0 acre quarter-quarter within a section. If the water right listed within a quarter-quarter is on more than one tax lot, this office has not identified that water rights for each tax lot - only a survey could accurately depict how much of the water rights are on each tax lot.

**Legend**

- OFF Certificate 42372, 43.8ac
- OFF Certificate 82877, 116.6 ac
- GI Ranch Outline
- Townships
- Sections
- Quarter quarters
- Local Road
- Secondary Road
- Private Road
- Water bodies
- Glaciers/snow fields
- Islands
- Wet areas
- Ditches, canals, flumes
- Pipelines, etc.
- Perennial stream names
- Intermittent or seasonal stream names

**ESTES SURVEYS, LLC**  
 Ramp Ferry Crossing  
 PO Box 17519 60382 Arnold Rd  
 Salem, OR 97305-7519 Bend, OR 97702  
 (503) 586-7503 (541) 382-7391


# TOWNSHIP 20 SOUTH, RANGE 22 EAST, W.M.

RECEIVED BY OWRD

MAR 10 2016

SALEM, OR

Scale 1"=1320'  
(4"=1 mile)

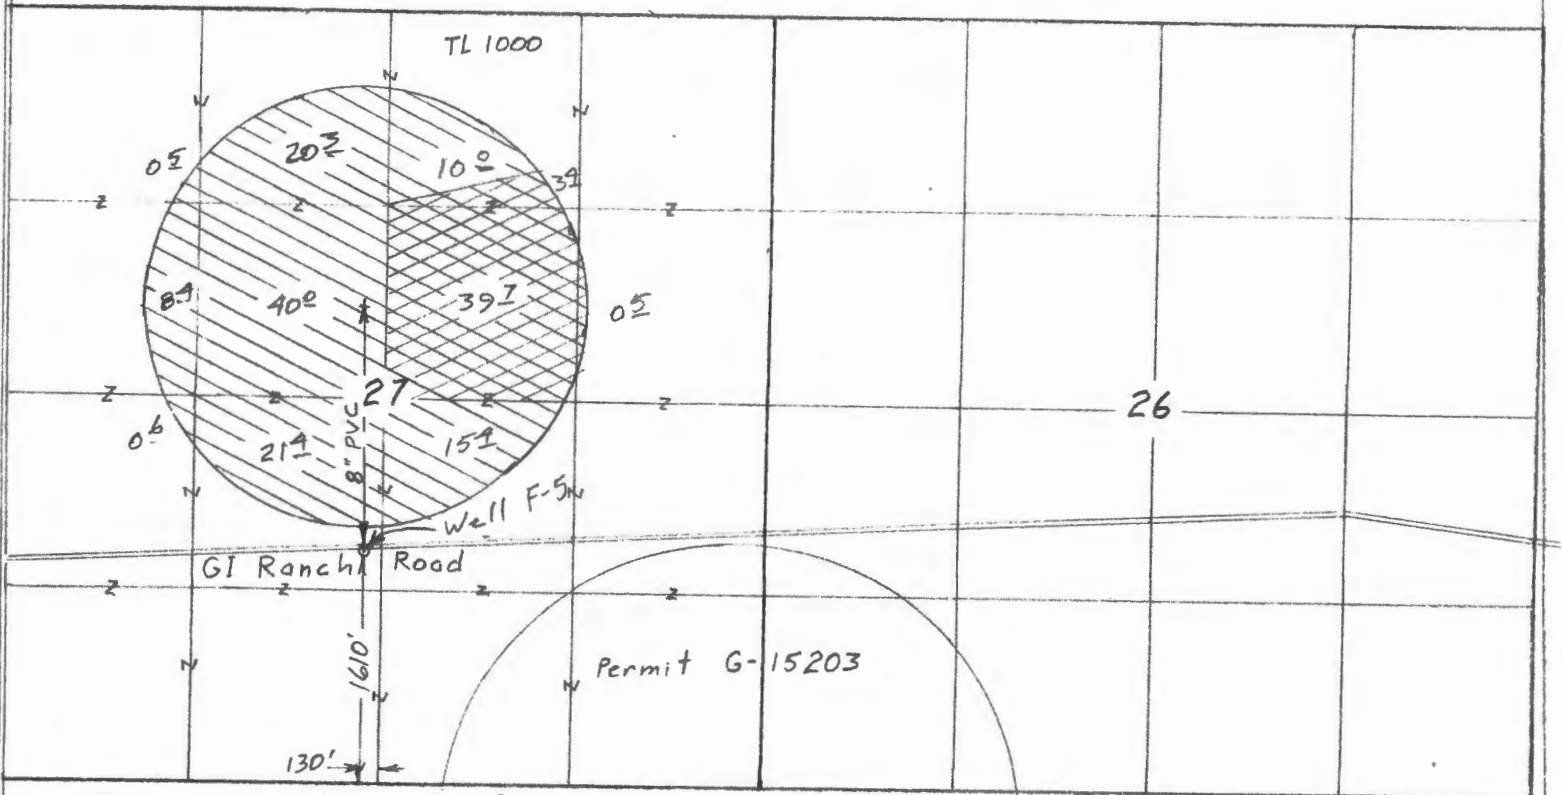


To: irrigation 160<sup>±</sup> acres

C-42372 43<sup>±</sup> ac.

C-B2877 116<sup>±</sup> ac.

Application Map  
for  
G.I. RANCH CORP.

T-11589

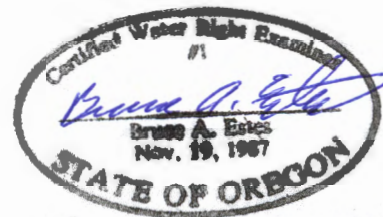

Renewal Dec 31, 2018

Sheet 2 of 4

This map is for the purpose of  
locating a water right only  
and has no intent to provide  
legal dimensions or the location  
of property lines.

**ESTES SURVEYS, LLC**

PO Box 17519  
Salem, OR 97306-7519  
(503) 565-7509

60352 Arnold Rd  
Bend, OR 97702  
(541) 382-7391