


TOWNSHIPS 20 & 21 SOUTH, RANGE 22 EAST, W.M.

RECEIVED BY CWRD

AN 00201
SALEM OR

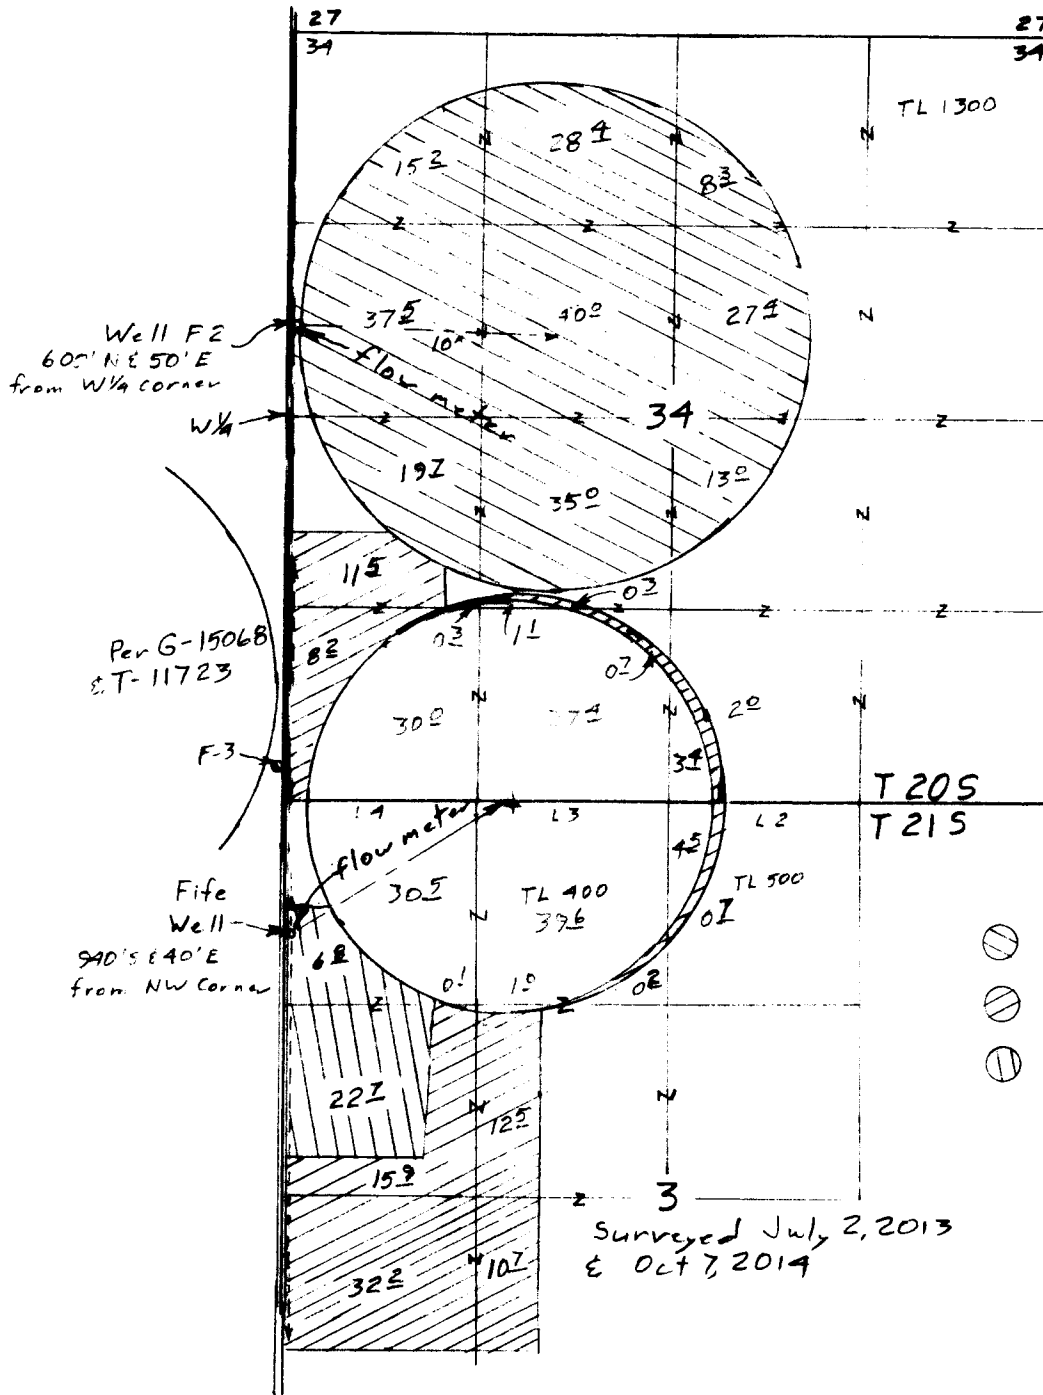


Scale 1" = 1320'
(4" = 1 mile)

App G-15171
Per G-15040

- ⊙ Well F-2 224[±] acres
- ⊙ Fife Well Primary 94[±] acres
- ⊙ Fife Well Supplemental 29[±] acres

Surveyed July 2, 2013
& Oct 7, 2014

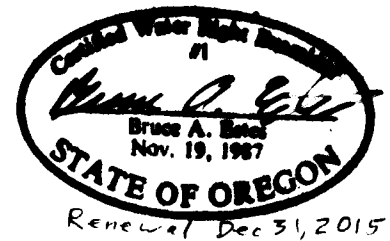

Claim of Beneficial Use Map for GI Ranch

This map is for the purpose of locating a water right only and has no intent to provide legal dimensions or the location of property lines.

ESTES SURVEYS, LLC

PO Box 47640
Salem, OR 97305-7519
(503) 586-7800

60382 Arnold Rd
Bend, OR 97702
(841) 382-7391

House Well C-82877

⊗ From 59^o acres

Fife C-90460



⊗ From 91^o acres

F-3 C-90461

⊗ From 11^o acres

○ Remain 228^o

Scale
1" = 1320'
(4" = 1 mile)

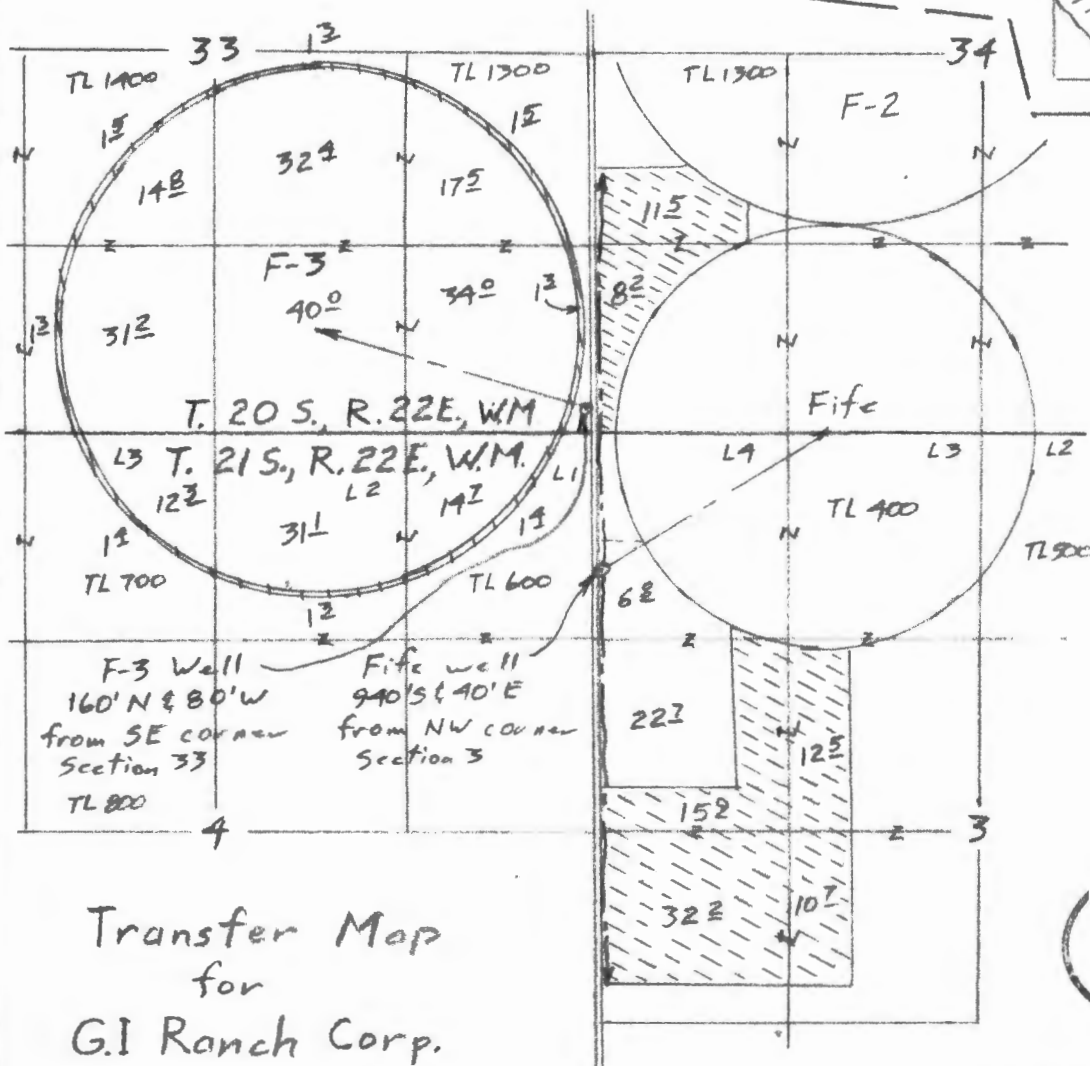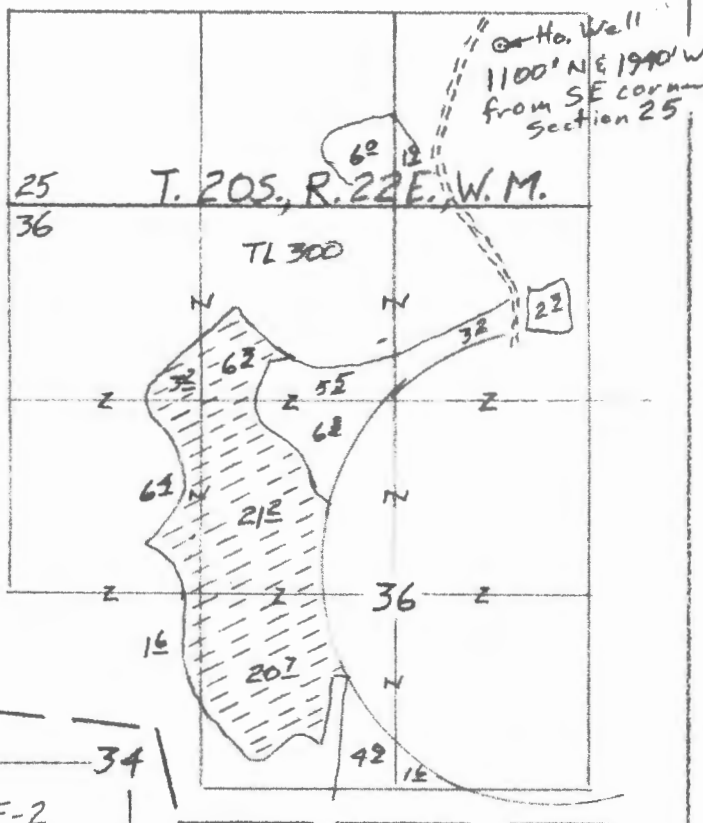

RECEIVED BY OWRD


MAR 10 2016

SALEM, OR

F-3 Well
160' N & 80' W
from SE corner
Section 33
TL 800

Fife well
940' S & 40' E
from NW corner
Section 3

Transfer Map
for
G.I Ranch Corp.

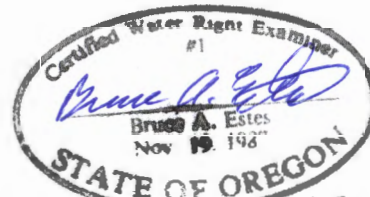

Renewal Dec 31, 2015
Sheet 3 of 4

This map is for the purpose of locating a water right only and has no intent to provide legal dimensions or the location of property lines.

ESTES SURVEYS

PO Box 17519
Salem, OR 97385-7519
(503) 586-7605

60382 Arnold Rd
Bend, OR 97702
(541) 382-7391